


T. 33 S., R. 2 E., W.M.

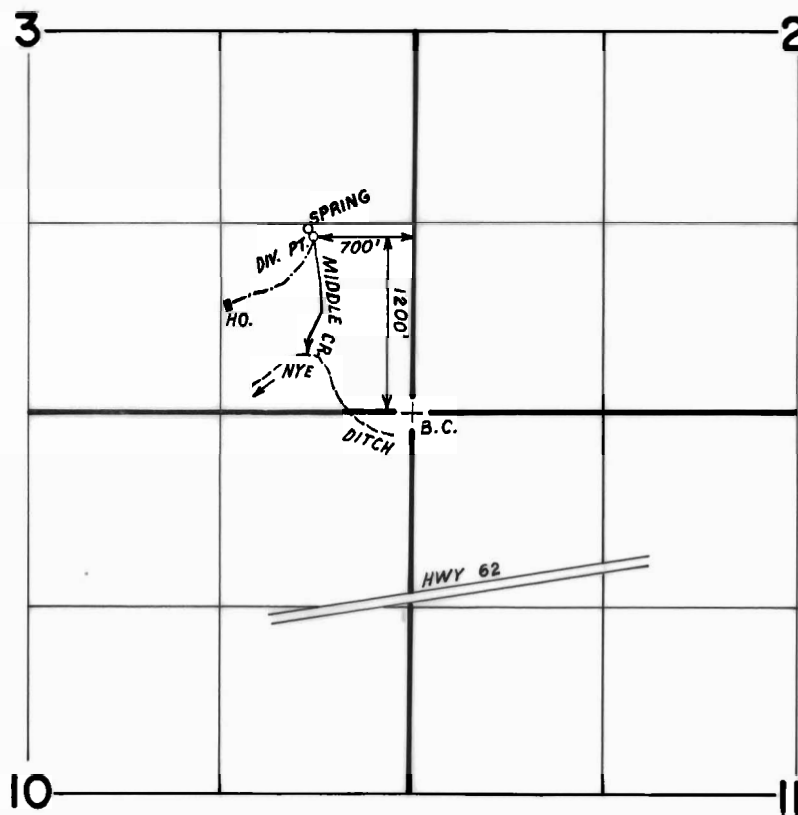

SCALE: 1" = 1320'

FINAL PROOF SURVEY
UNDER

Application No. **57974** Permit No. **43623**
IN NAME OF

SUZANNE NURRE

Surveyed **JUNE 16 1983**, by **B. S. JAMES**