


T.12S., R.11W., W.M.

SEC. 6

SW $\frac{1}{4}$ SE $\frac{1}{4}$

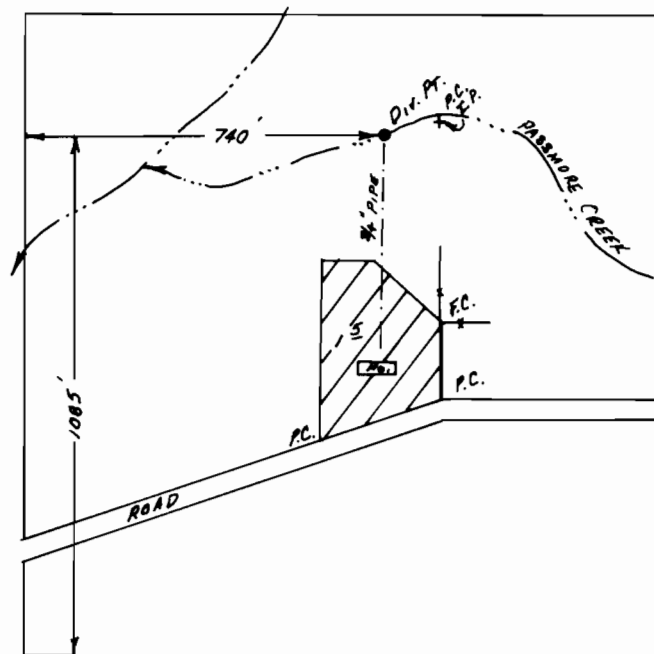

SCALE: 1" = 400'

FINAL PROOF SURVEY
UNDER

Application No. 57832... Permit No. 43700.....
IN NAME OF

CLIFFORD & ORTHAL PASSMORE

Surveyed Sept. 19... 1983, by L.M. TOLL.....