


T. 9S., R. 35 1/2 E., W. M.

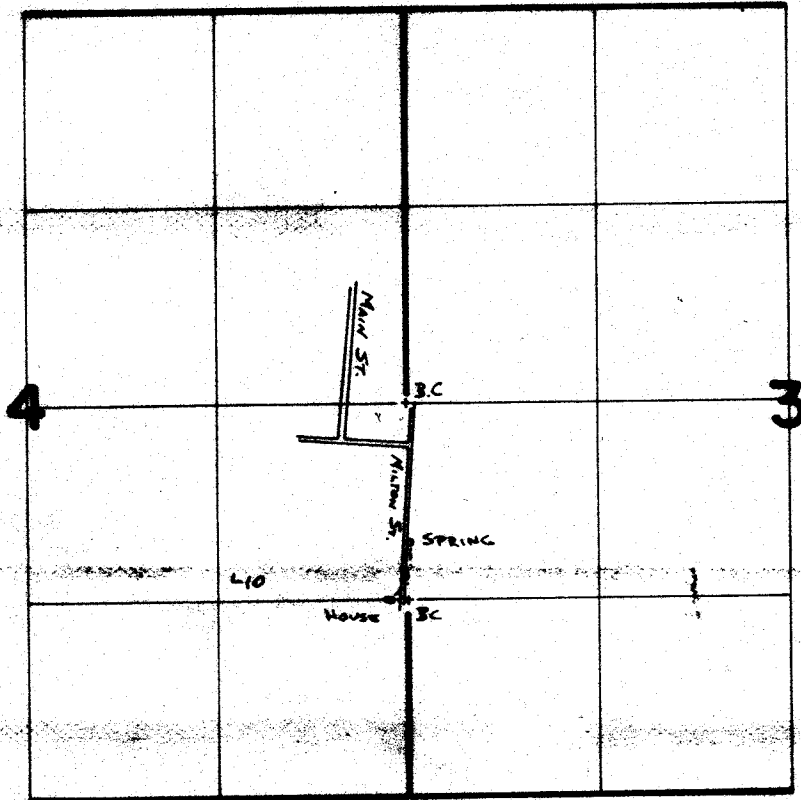

N

SCALE = 1320'

SPRING Loc: 950'S. & 10'E. FROM W/4 COR. SEC. 3

FINAL PROOF SURVEY
UNDER

Application No. **57992** Permit No. **43720**
IN NAME OF

BILL L. & JAUNITA WATKINS

Surveyed **4-21** 19**86**, by **L. M. TOLL**