


T. 34S., R. 6W., W.M.

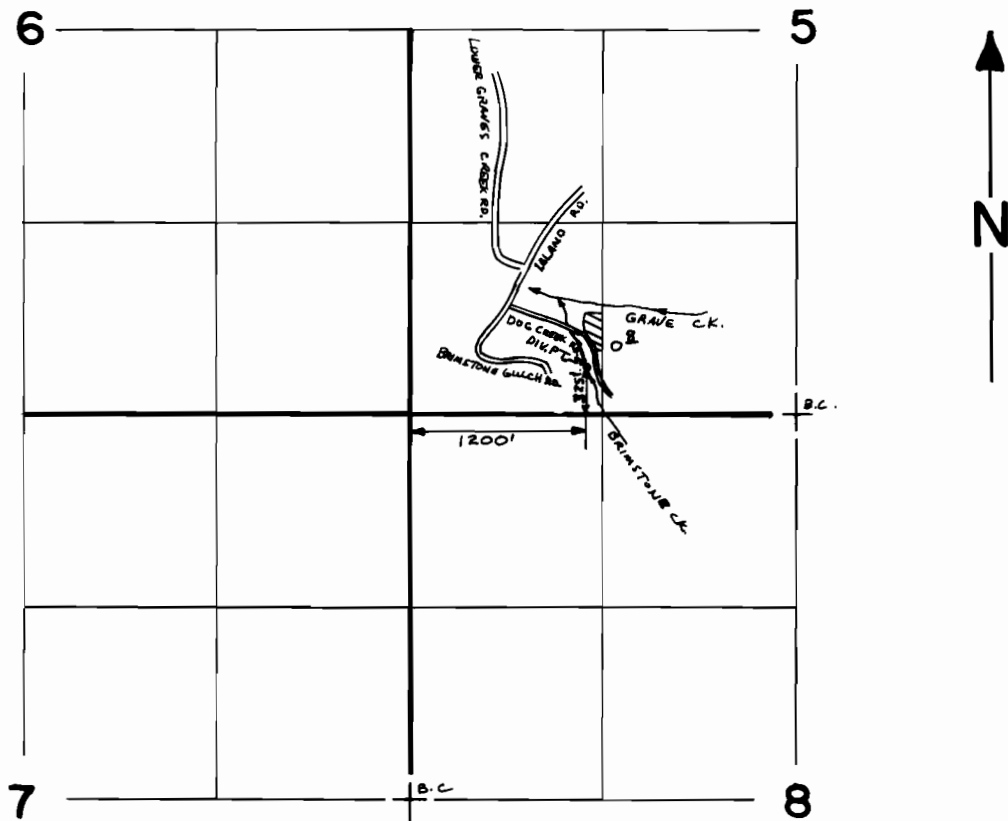

SCALE 1" = 1320'

**FINAL PROOF SURVEY**  
UNDER

Application No. 58127..... Permit No. 43736.....  
IN NAME OF

**MIKE BRANSEN & CATHERINE LORENZ**

Surveyed SEPT. 6 1984 by J. WOODROOF  
FEB. 14, 1985 " " " "