


T.IOS.,R.IW.,W.M.

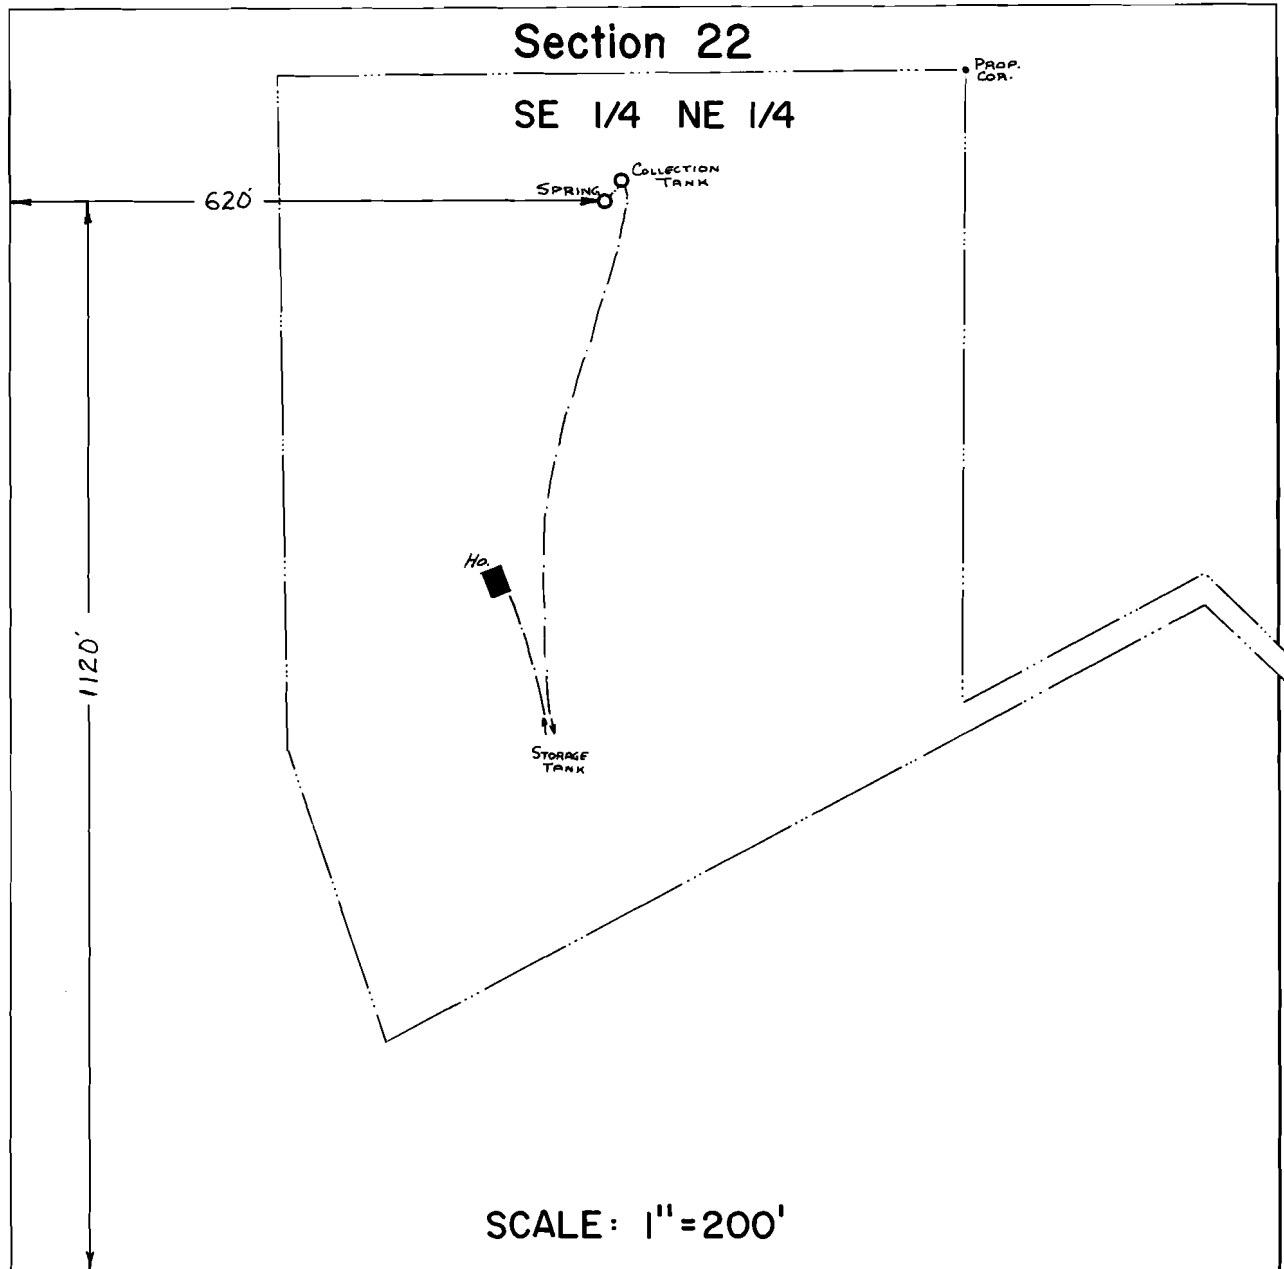

FINAL PROOF SURVEY UNDER

Application No. .58073.. Permit No. ...43768.....

IN NAME OF
MARK W. HAFFNER &
B. JOAN KAUFFMANN.....

Surveyed June...3... 19.82., by L.M. TOLL.....