


T.15S.,R.5W.,W.M.

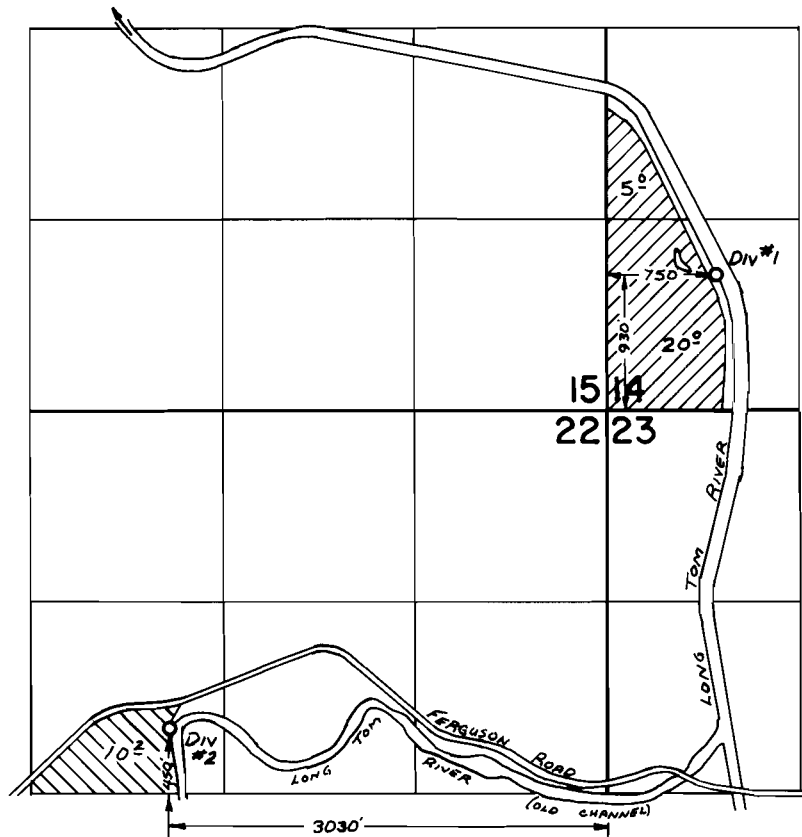

FINAL PROOF SURVEY
UNDER

Application No. 58262. Permit No. 43869.....
IN NAME OF

RONALD E. DETERING

Surveyed Aug. 2, 1982, by L.M. TOLL.....