


T. 4 S., R. 6 W. WM.

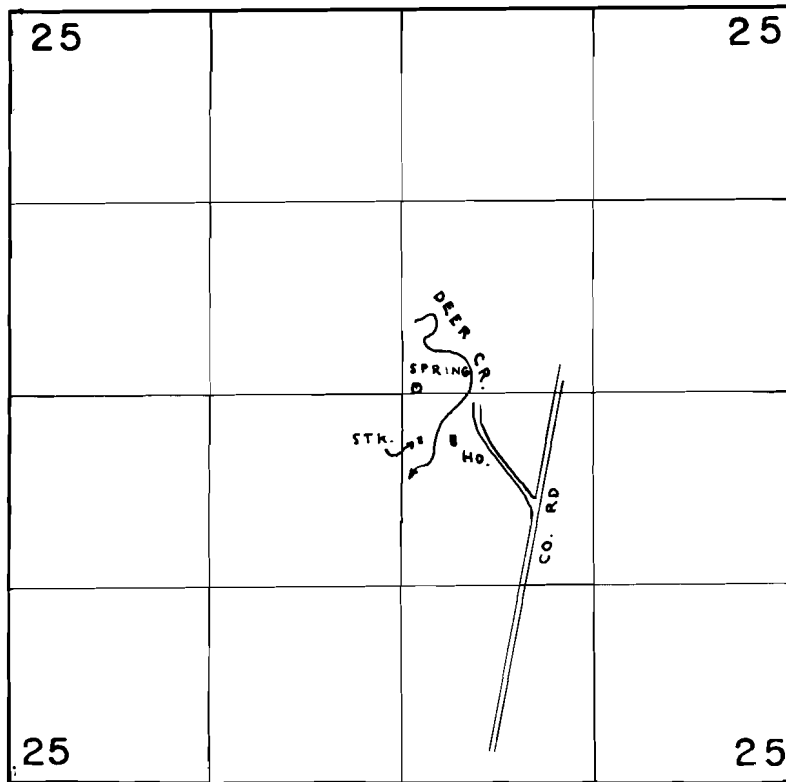

N

SCALE
1" = 1320'

DIV. PT. LOC.: 2700' N & 100' E. OF 1/4 COR. SEC. 25

FINAL PROOF SURVEY
UNDER

Application No. 58311 Permit No. 43870
IN NAME OF

DONALD E. THOMAS

Surveyed NOV 15, 1984, by P. THRELKELD