


T. 29S. R. 4W. W.M.

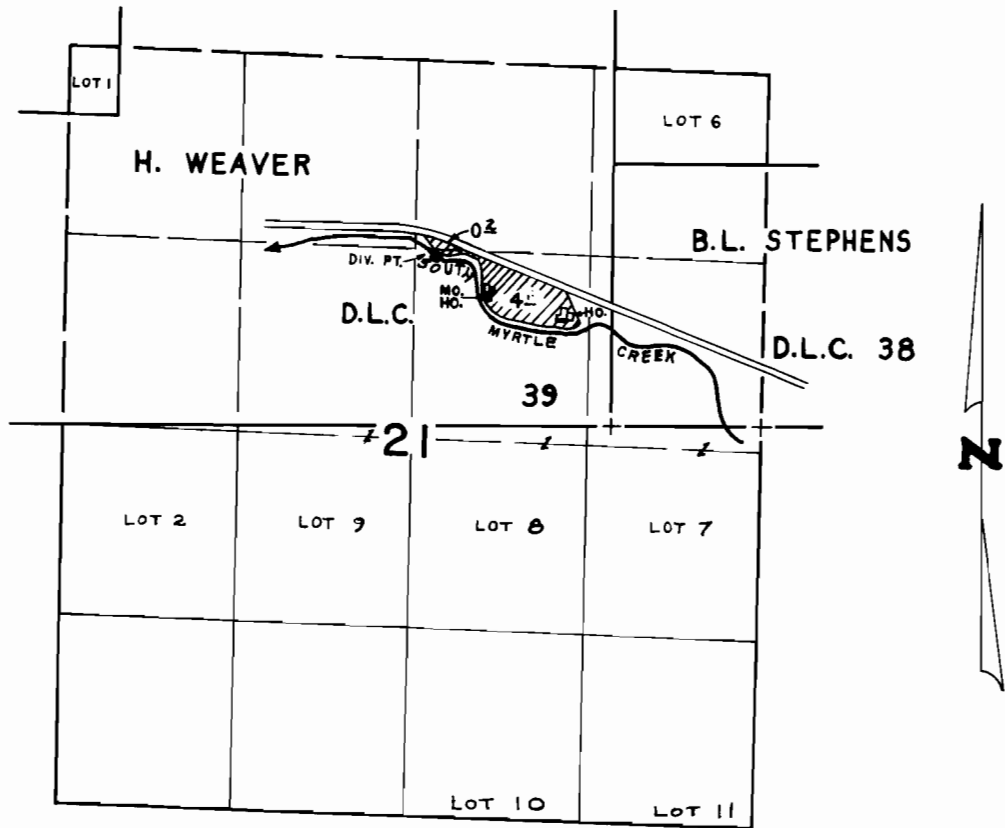

DIV. PT. LOCATED 1260' N. & 1210' W. FROM S.E. CORNER D.L.C. 39

SCALE: 4" = 1 mile

FINAL PROOF SURVEY UNDER

Application No. 61005.. Permit No. 45484.....
IN NAME OF

HOWARD L. JR. & MARTHA J. BROWNSON

Surveyed DEC. 30, 1983, by L. CASHION...