


P-47052  
C-57908

T. 9S., R. 35 1/2 E., W. M.

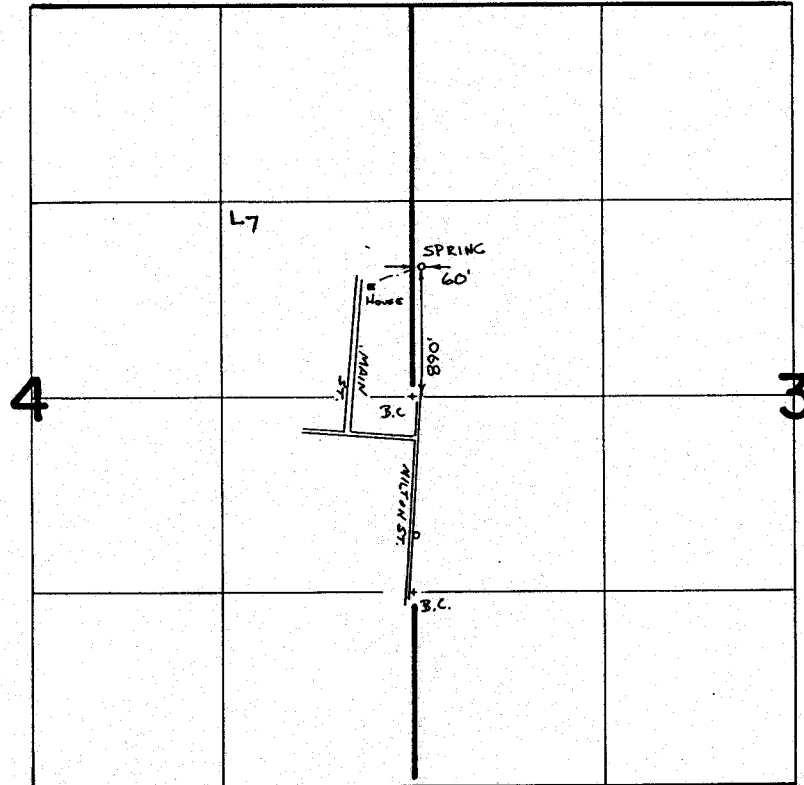

SCALE 1" = 1320'

**FINAL PROOF SURVEY**  
UNDER

Application No. **63951**. Permit No. **47052**..  
IN NAME OF

**HAROLD MEDLER**

Surveyed **4-21** 198**6**, by **J. M. Toll**