


T. 34S., R. 6 W., W.M.

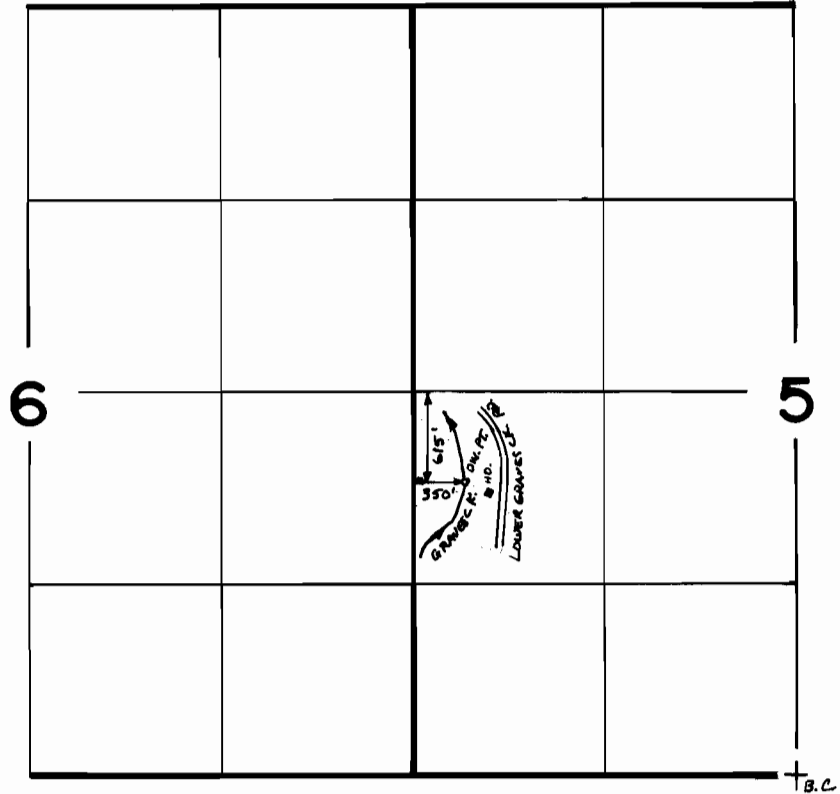

SCALE: 1"=1320'

FINAL PROOF SURVEY
UNDER

Application No. 65105... Permit No. 47819.....
IN NAME OF

KENNITH S. RUSSELL.....

Surveyed SEPT. 6... 1984., by J.R. WOODRUFF.