


T. 26 S., R. 3 W., W.M.

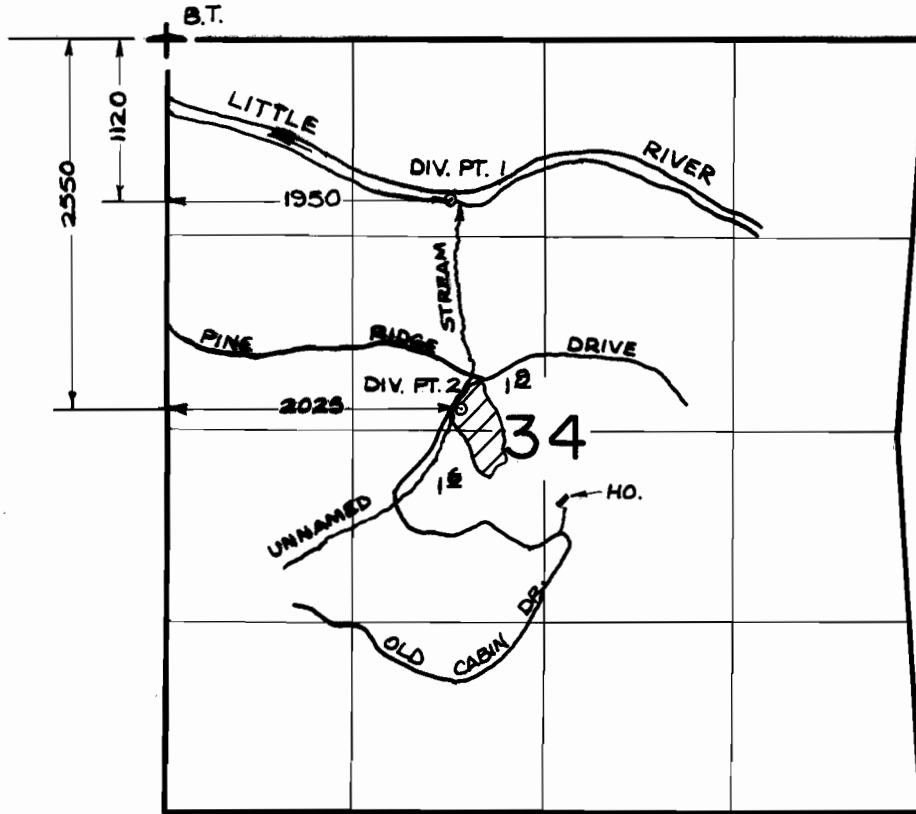

SCALE : 4" = 1 MILE

FINAL PROOF SURVEY UNDER

Application No. 6508 Permit No. 47889
IN NAME OF

ROBERT & CAROL FOLEY

Surveyed OCT. 2, 1986, by J.M. SCHMORDE