
T.38S. R.5W. W.M.

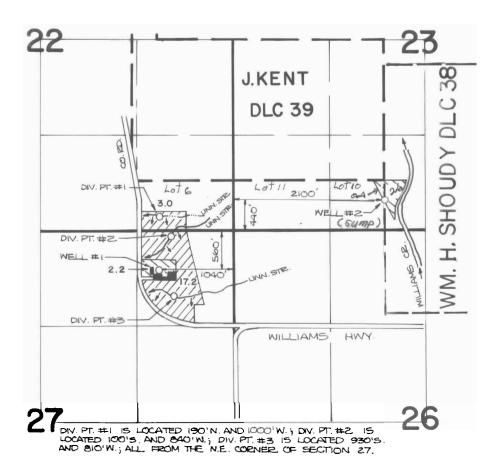

PERMIT 37368 PERMIT G-5591

FINAL PROOF SURVEY

UNDER

G-5853 G-559I
Application No. 49523 Permit No. 37368
IN NAME OF

JOSEPH J & SUZANNE GINET

Surveyed AUG. 4. 1983, by B. JAMES