


6-4904

G-6678 57916
T9461

G 7336-
57927

T.25S. R.17 & 18E. W.M.

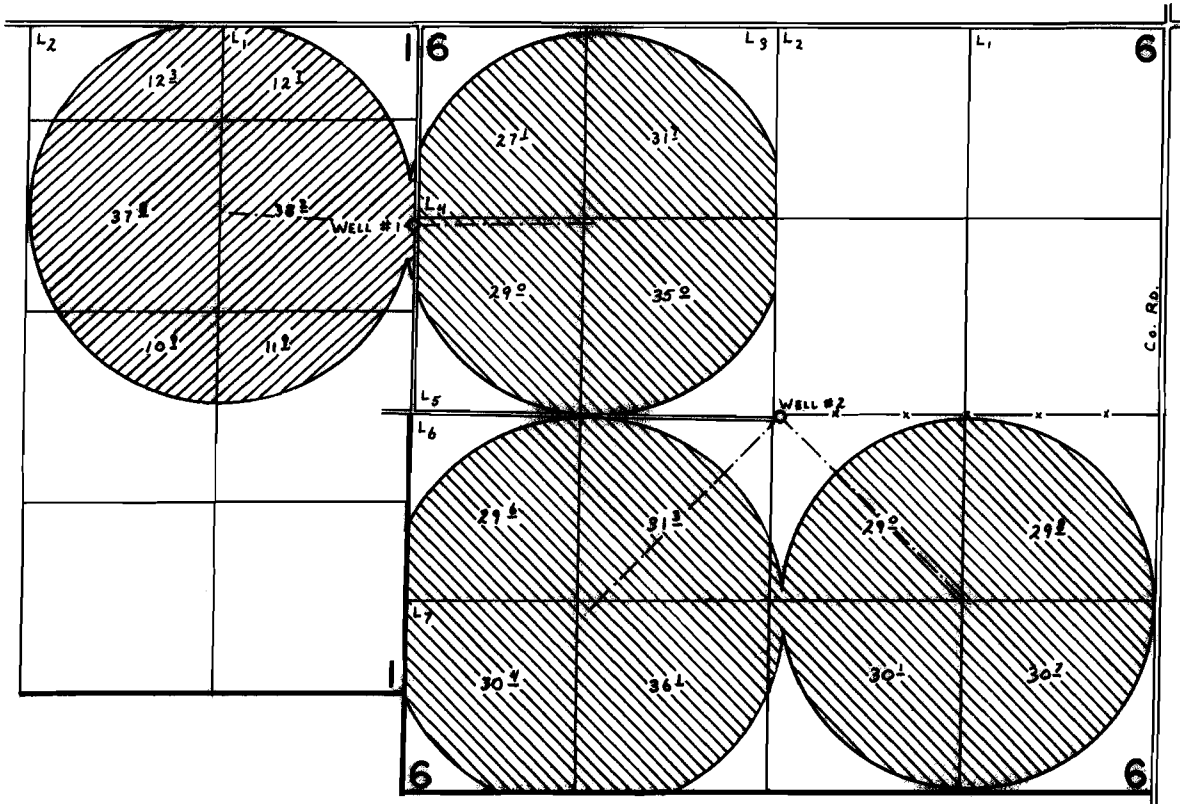

WELLS LOC:
 #1- 1370'S. § 20' W. fr. N.E. COR. SEC. 1.
 #2- 2680'S. § 2600' W. fr. N.E. COR. SEC. 6.

FINAL PROOF SURVEY UNDER

G-7059 G-6678
 Application No. ~~G-8180~~ Permit No. ~~G-7336~~
 IN NAME OF

WHITE SAGE FARMS, INC.

Surveyed Aug. 27, 1979, by C. L. HUGHES