
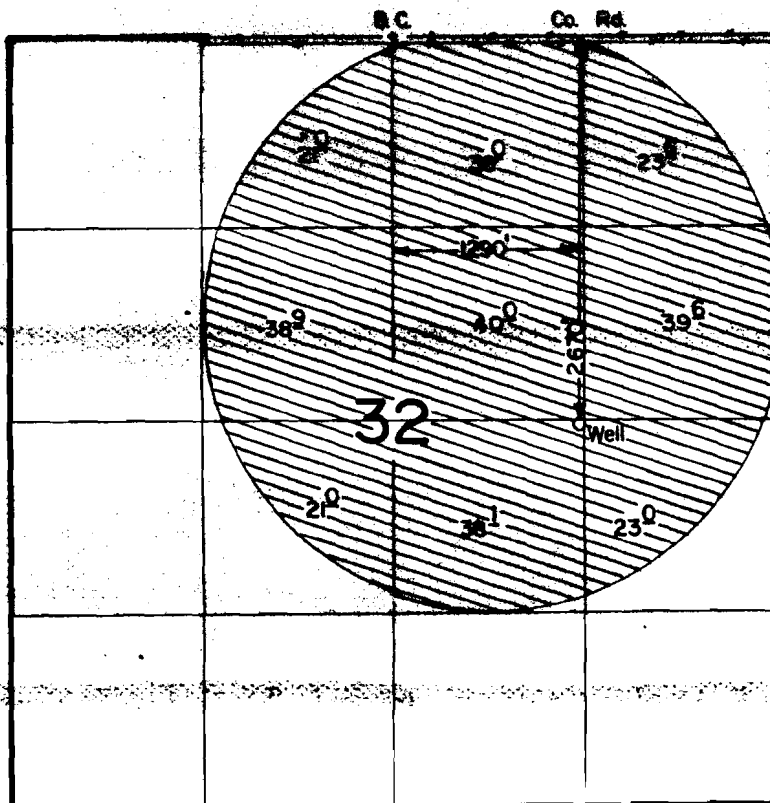


G-6868
57918

T. 26 S., R. 15 E., W. M.

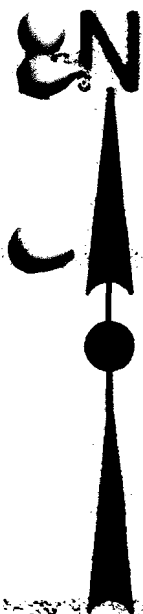

Scale: 1" = 1320'

FINAL PROOF SURVEY
UNDER

Application No. G-7370.. Permit No. G-6868.....
IN NAME OF

ROBERT R. TUTTLE

Surveyed Oct. 11, 1985., by J. Warren.....