


P. 5594
5792

135-30E,

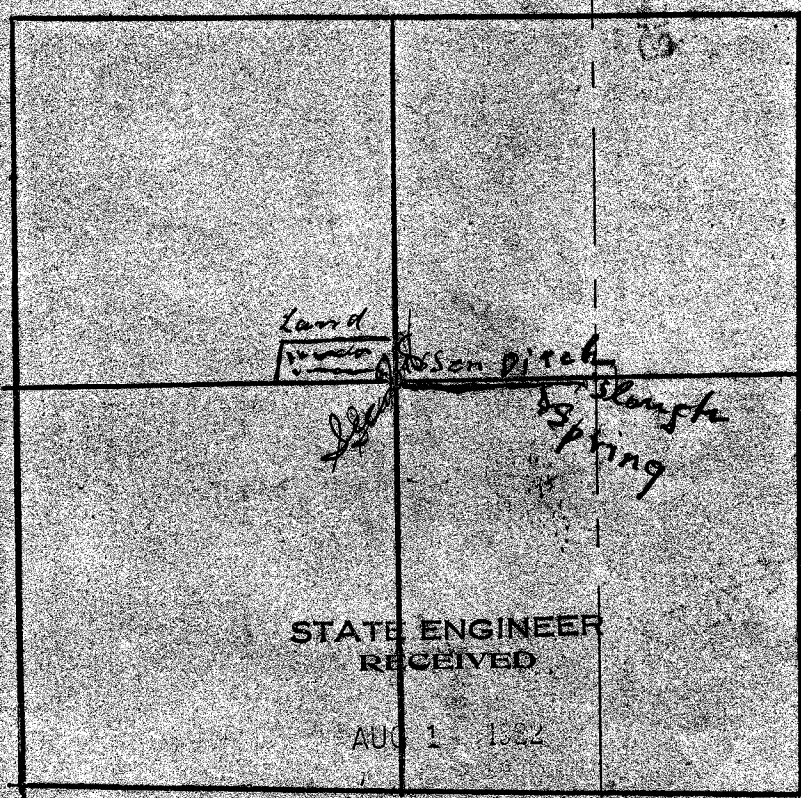

STATE ENGINEER
RECEIVED

AUG 1 1924

SALEM, OREGON

Application No. 8542
Permit No. 5594

8213

RECORDED
INDEXED