


T.8S., R.39E., W.M.

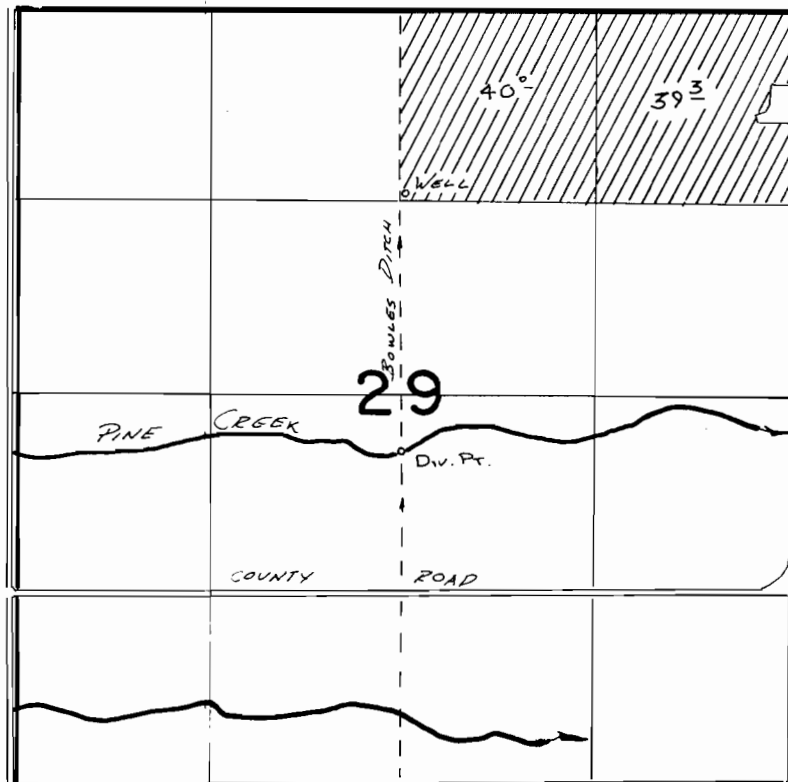

Div. Pt. Loc: 2280'N & 2640'E. FROM SW COR SEC 29
WELL LOC: 1380'N. & 40'E. FROM CENTER COR. SEC 29

FINAL PROOF SURVEY
UNDER

TRANSFER 3554

Application No. **G:7856** Permit No. **G:7283**
IN NAME OF

WILLIAM J. PIERCE

Surveyed July 13, 1987, by W. L. Auch

COPY