


G-7408  
57930

# T.37S. R.20E. W.M.

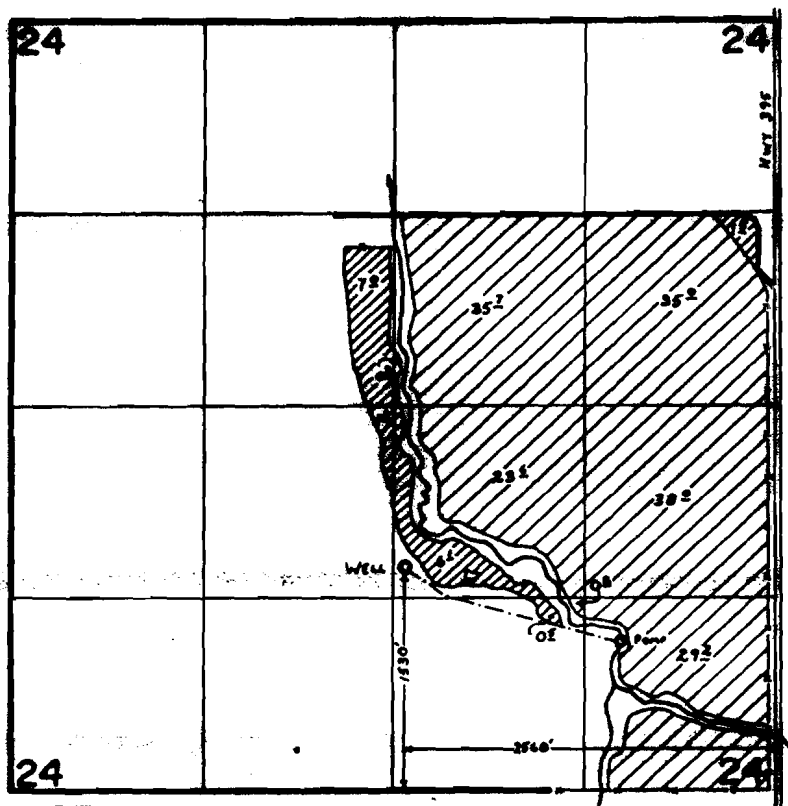

▨ - PRIMARY IRRIGATION  
▩ - SUPPLEMENTAL IRRIGATION

## FINAL PROOF SURVEY UNDER

Application No. ~~G-7981~~ Permit No. G-7408  
IN NAME OF

ROBERT L. WEIR

Surveyed June 8, 1980, by C. L. Hughes