


T.10S.,R.2W.,W.M.

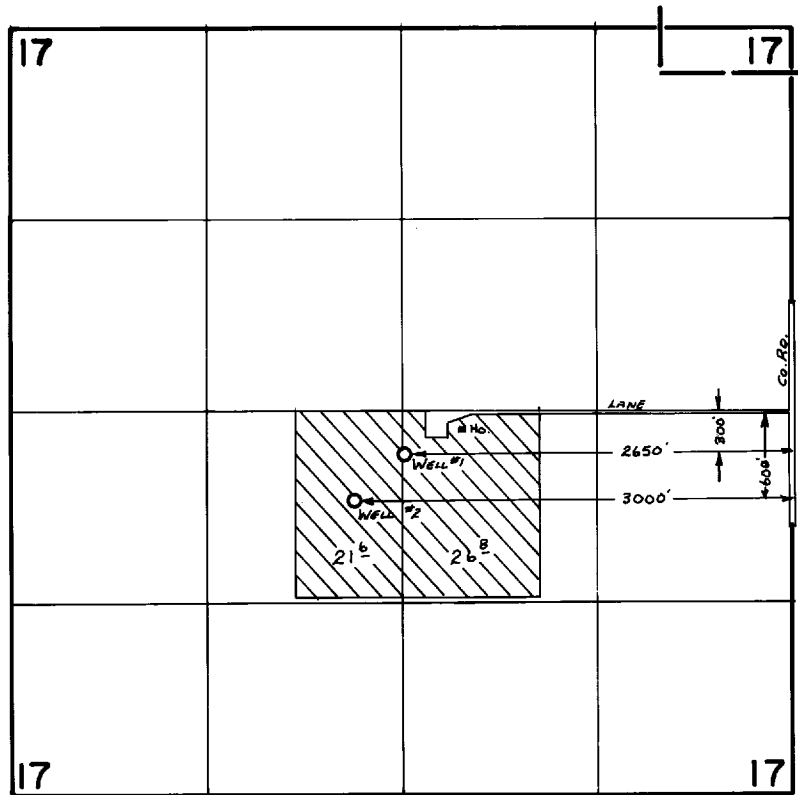

FINAL PROOF SURVEY UNDER

Application No. G-8276. Permit No. G-7587.....
IN NAME OF

.....LESTER G. SHAW.....

Surveyed July 6..... 1982., by L. M. TOLL.....