


T. 4 S., R. 1 E., W.M.

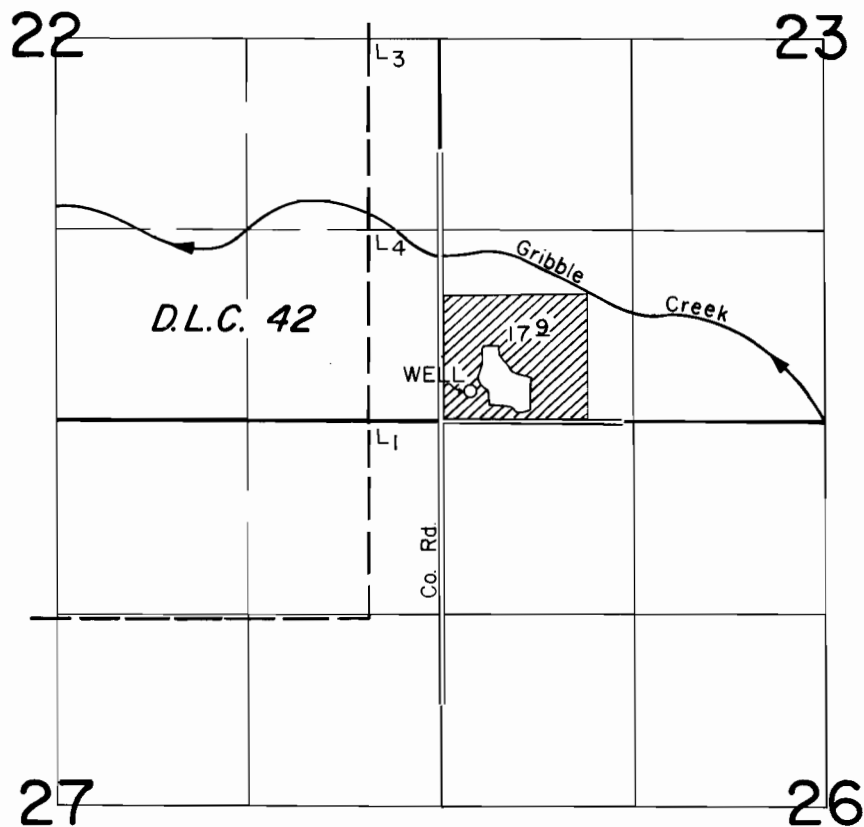

WELL LOC: 200' N. & 200' E. FROM THE S.W. CORNER SECTION 23

SCALE: 1" = 1320'

FINAL PROOF SURVEY

UNDER

Transfer No. 5917

Application No. G-8429. Permit No. G-7896
IN NAME OF

JOHN J. RENZEMA

Surveyed JULY 2, 1985, by T. WARREN
SEPT. 14 1987