
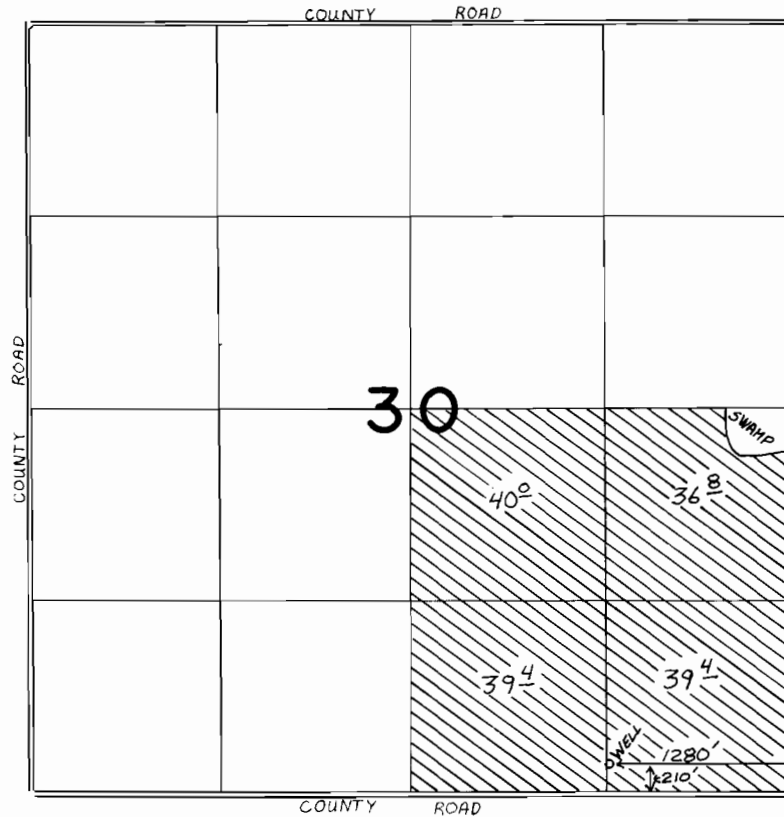


T. 1 S., R. 39 E., W. M.

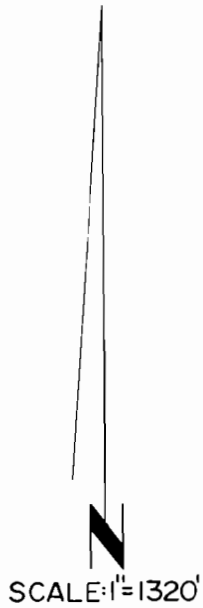

FINAL PROOF SURVEY
UNDER

Application No. G-11242 Permit No. G-10365
IN NAME OF

ELWYN BINGAMAN

Surveyed MAY 22, 1986, by V.L. CHURCH