


T.18S.,R.6W.,W.M.

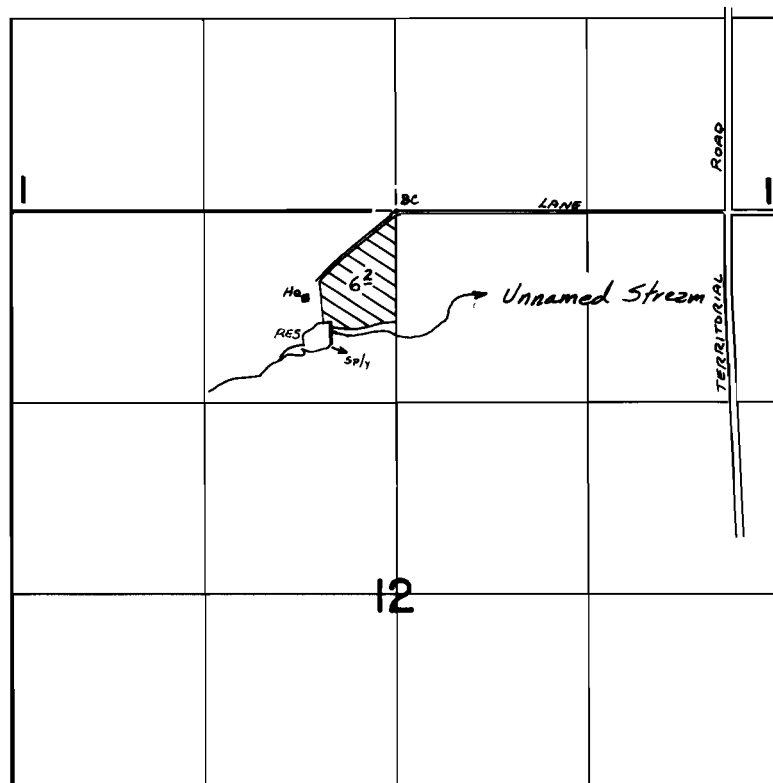

DAM LOC: 840 FT. S AND 450 FT. W FROM N¹/₄ COR SEC 12

FINAL PROOF SURVEY UNDER

R-56329 R-6663
Application No. 56327 Permit No. 42016.....
IN NAME OF

KARL F. & OLGA E. ENTENMANN

Surveyed May 6, 1982, by L. M. TOLL.....