


# T.36S., R.1E., W.M.

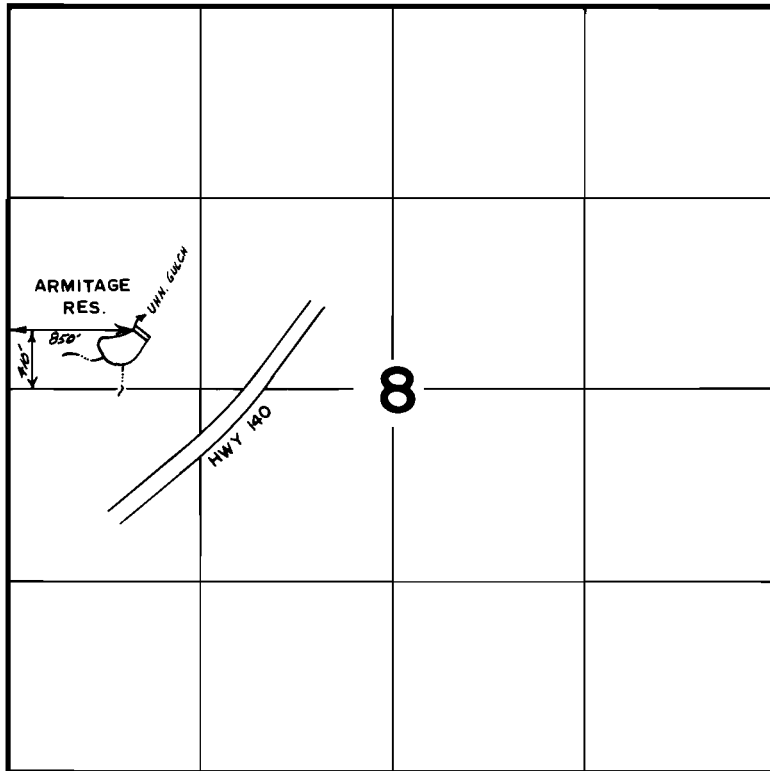

Scale 1" = 1320'

## FINAL PROOF SURVEY UNDER

R-49753

R-6709

Application No. ~~55543~~ Permit No. ~~42378~~.....

IN NAME OF

GARY P. &/or DOUGLAS L. HOSKING

Surveyed JUNE 13, 1984, by B.S. JAMES.....