T.8S. R.4W. W.M.

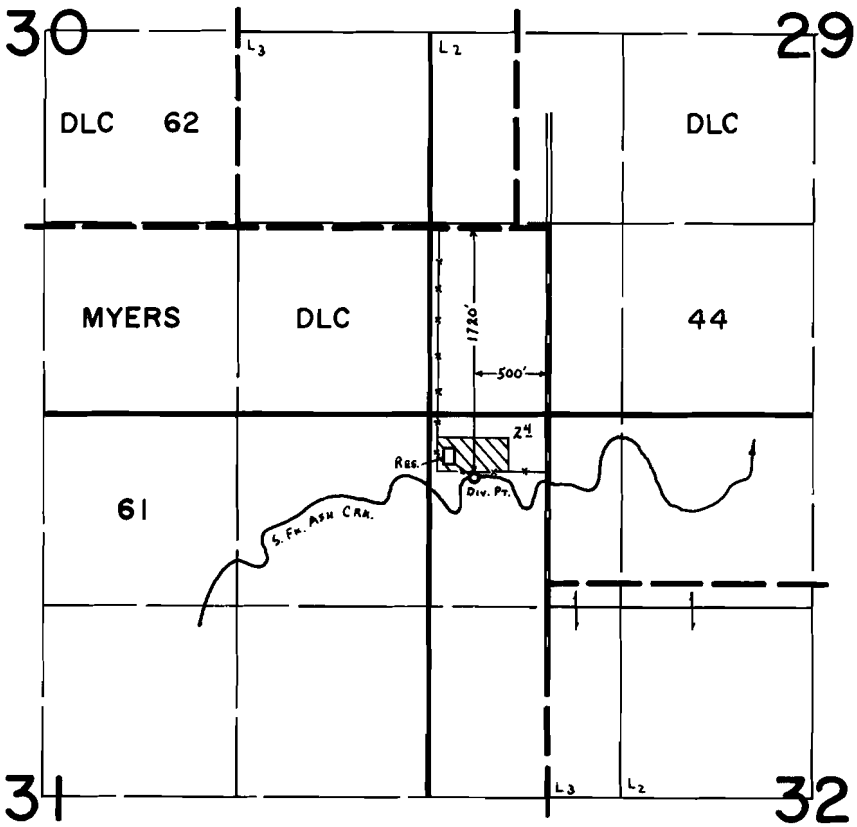

FINAL PROOF SURVEY

UNDER

Application No. R-53404 53405 Permit No. R-6369 39617

IN NAME OF

SHERMAN WESTON

Surveyed July 20 19 79, by C. L. HUGHES

DFP-244-97