


T.8S. R.4 W. W.M.

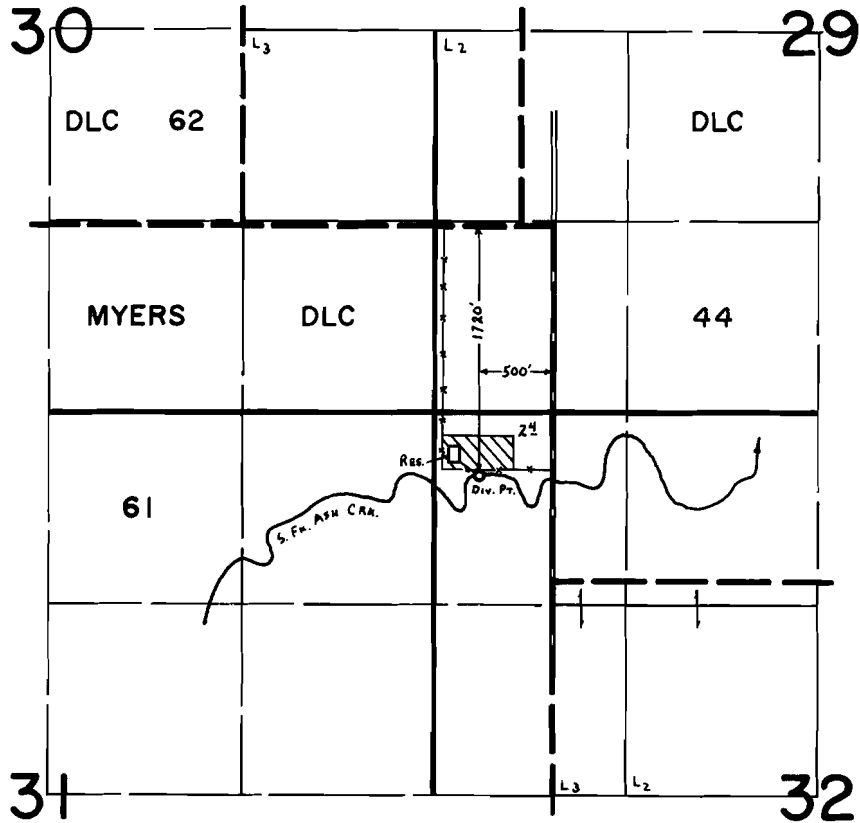

**FINAL PROOF SURVEY**  
UNDER

R-53404                      R-6369  
Application No. 53405 Permit No. 396.1.7.....  
IN NAME OF

.....**SHERMAN WESTON**.....

Surveyed July 20 1979, by C. L. HUGHES.....