


T.2S., R.2W., W.M.

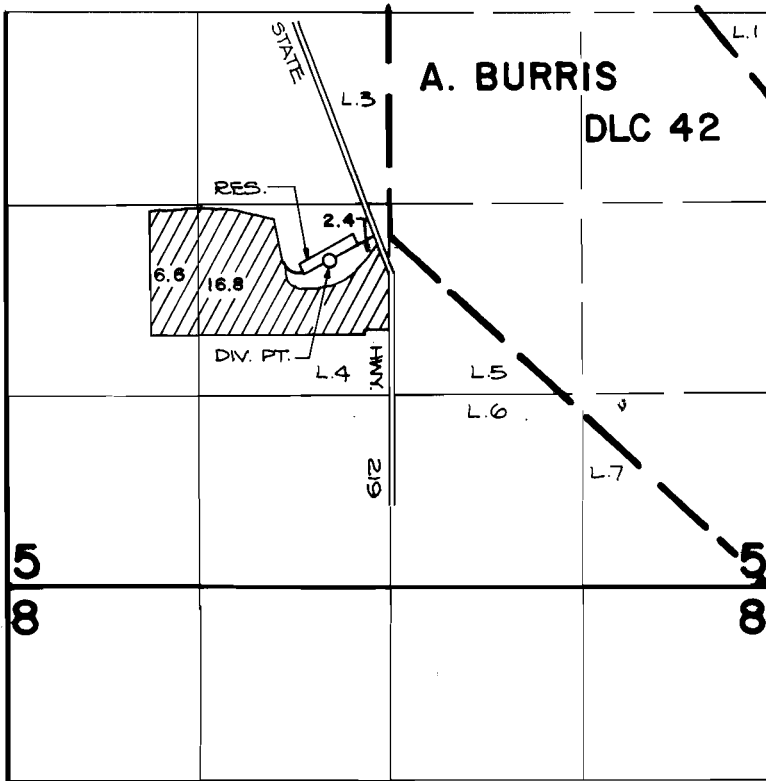

DIV. PT. IS LOCATED S. 46° 30' N. 570' FROM THE N.E. CORNER OF THE NE 1/4 SW 1/4 OF SECTION 5.

SCALE: 4" = 1 MILE

FINAL PROOF SURVEY UNDER

R-53660

R-6408

Application No. ~~53661~~ Permit No. ~~40125~~.....

IN NAME OF

.....**JEAN FRIEDEN**.....

Surveyed ~~NOV. 15~~ 19~~83~~, by ~~L. TOLL~~.....

