


T.8S.,R.6W.,W.M.

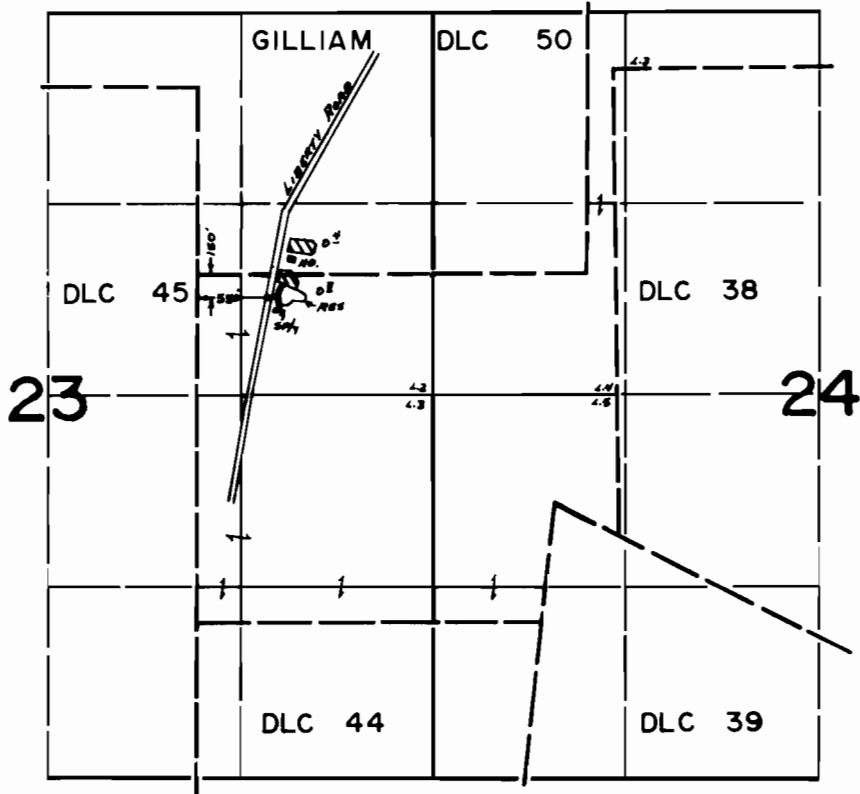

FINAL PROOF SURVEY UNDER

R-56828 R-6763
Application No. 56829 Permit No. 42627
IN NAME OF

MIKE MCCRISTAL

Surveyed Sept. 9 1981, by L. TOLL