


T.8S.,R.6W.,W.M.

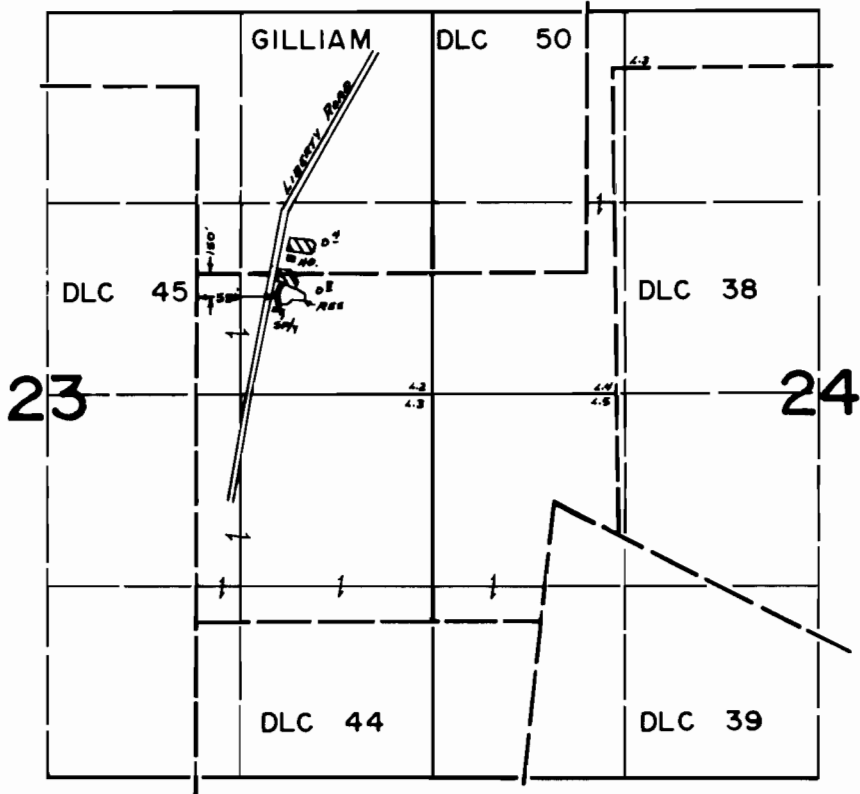

FINAL PROOF SURVEY UNDER

Application No. R-56828 56829 Permit No. R-6763 42627

IN NAME OF

MIKE MCCRYSTAL

Surveyed Sept. 9 1981, by L. TOLL