


T. 38 S., R. 1 W., W. M.

Sec. 35

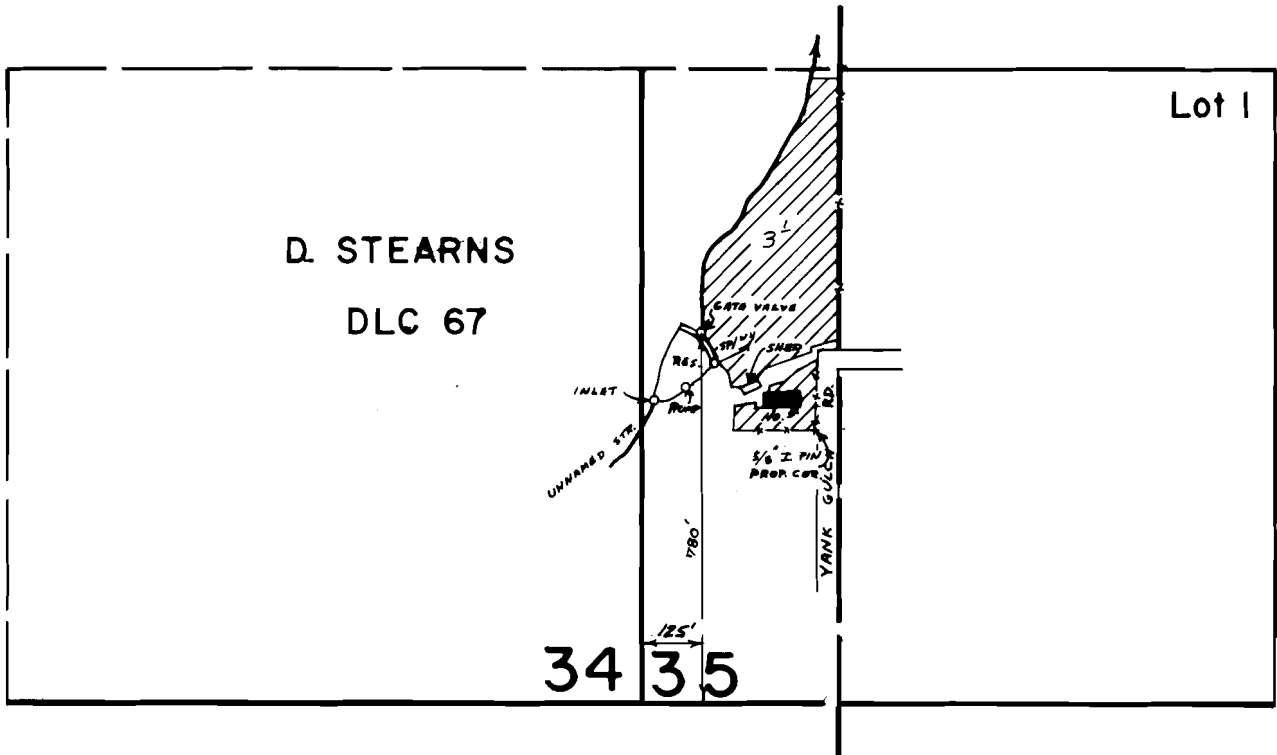

Scale : 1" = 400'

FINAL PROOF SURVEY
UNDER

R-54453

R-6511

Application No. **54454** Permit No. **40833**... SUPP'L
IN NAME OF

.....*William S. and Shannon M. Foster*.....

Surveyed **AUG. 26, 1981**., by **BRUCE R. SUND**