


T.35 S., R.1 E. , W.M.

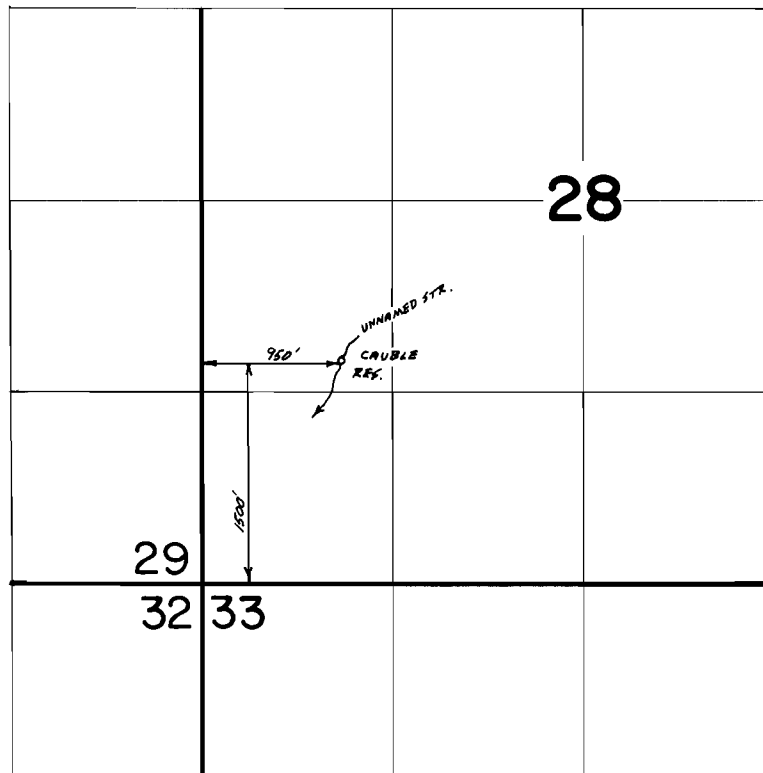

SCALE 1" = 1320'

FINAL PROOF SURVEY
UNDER

R-57342

R-7681

Application No. 57343 Permit No. 43339.....

IN NAME OF

LAWRENCE M. & DORIS SUE CAUBLE

Surveyed JUNE 12, 1984, by B.S. JAMES.....