


T.11S., R.1W., W.M.

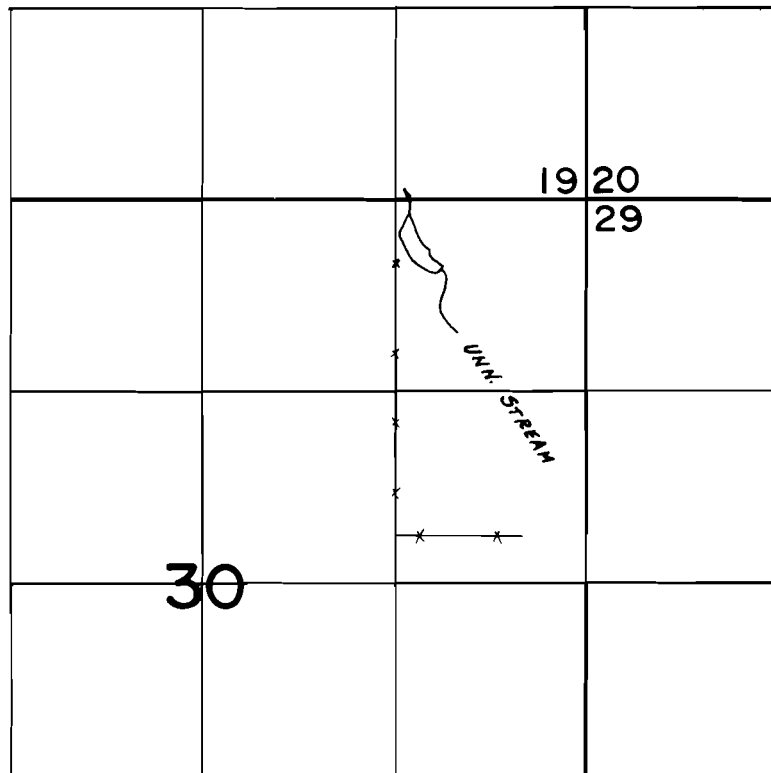

DIV. PT. LOC. 100'S. & 1200' W. FROM NE COR. SEC. 30

FINAL PROOF SURVEY
UNDER

Application No. R-57564 Permit No. R-7693.....
IN NAME OF

.....JAMES W. MACPHERSON.....

Surveyed JUNE 1.... 1982, by L.M. TOLL.....