


T.4S. R.4W. W.M.

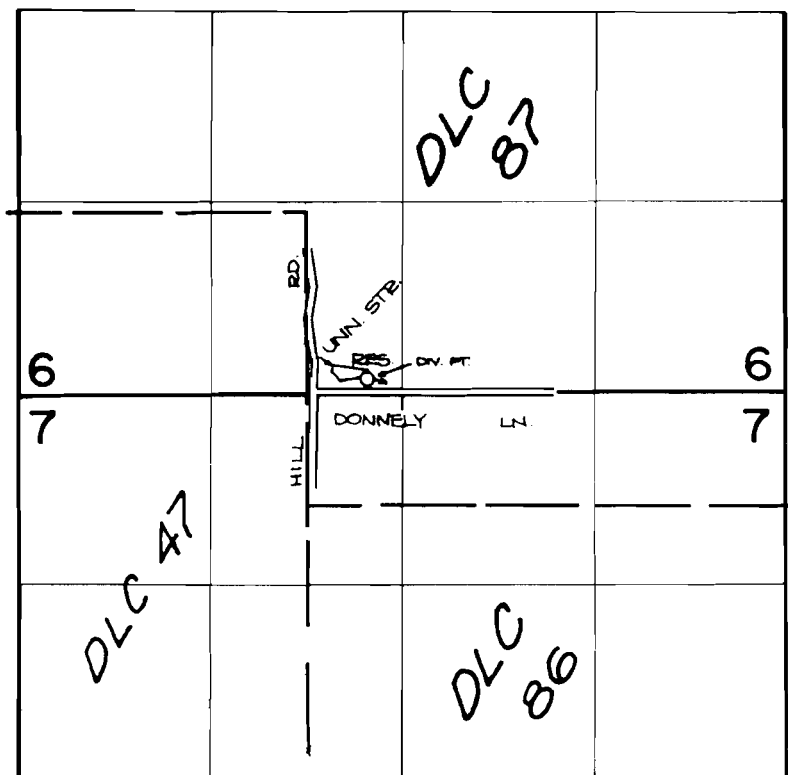

DIVERSION POINT IS LOCATED 70' N. AND 250' W. FROM THE S. 1/4 CORNER OF SECTION 6.

FINAL PROOF SURVEY
UNDER

R-57898

R-7798

Application No. 57899 Permit No. 43929

IN NAME OF

W.L. & NORMA C. EDWARDS

Surveyed SEPT. 29, 1983, by P. P. Patten