


T.1N., R.4W., W.M.

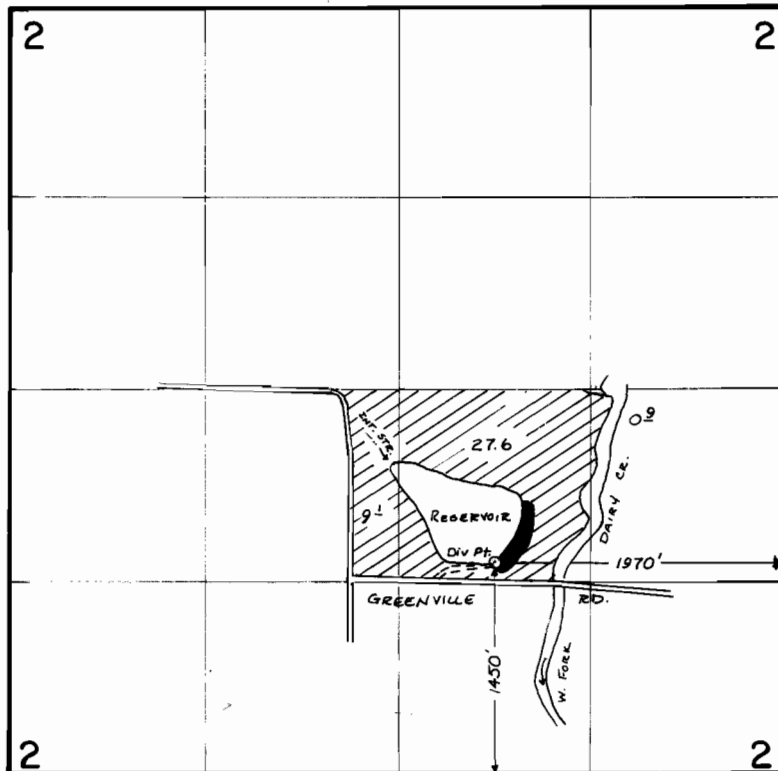

SCALE : 1" = 1320'

FINAL PROOF SURVEY

UNDER

57560 44037
Application No. R-57559.. Permit No. R-7814....
IN NAME OF

.....GLENN WALTERS.....

Surveyed ...NOV.1... 1983., by ..L..TOLL.....