


T.4S.,R.3E.,W.M.

SECTION 32

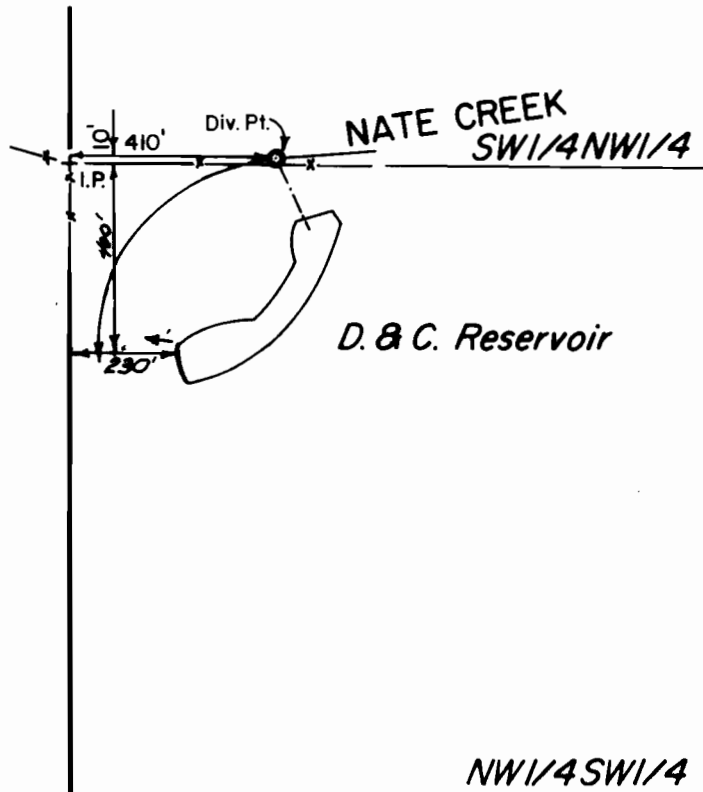

SCALE 1" = 400'

FINAL PROOF SURVEY UNDER

R-59198 R-7937
Application No. 59199 Permit No. 44415
IN NAME OF

DENNIS J. BROWN

Surveyed AUG. 11, 1981, by *[Signature]*