


# T.4S.,R.3E.,W.M.

## SECTION 32

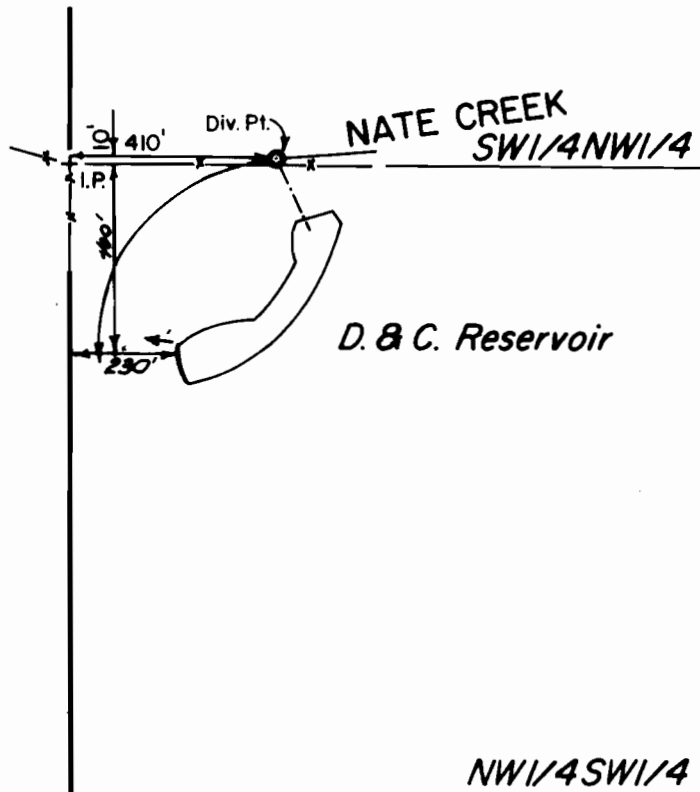

SCALE 1" = 400'

### FINAL PROOF SURVEY UNDER

R-59198                      R-7937  
Application No. 59199      Permit No. 44415  
IN NAME OF

DENNIS J. BROWN

Surveyed AUG. 11, 1981, by *[Signature]*