


T. 6 S., R. 2 W., W. M.

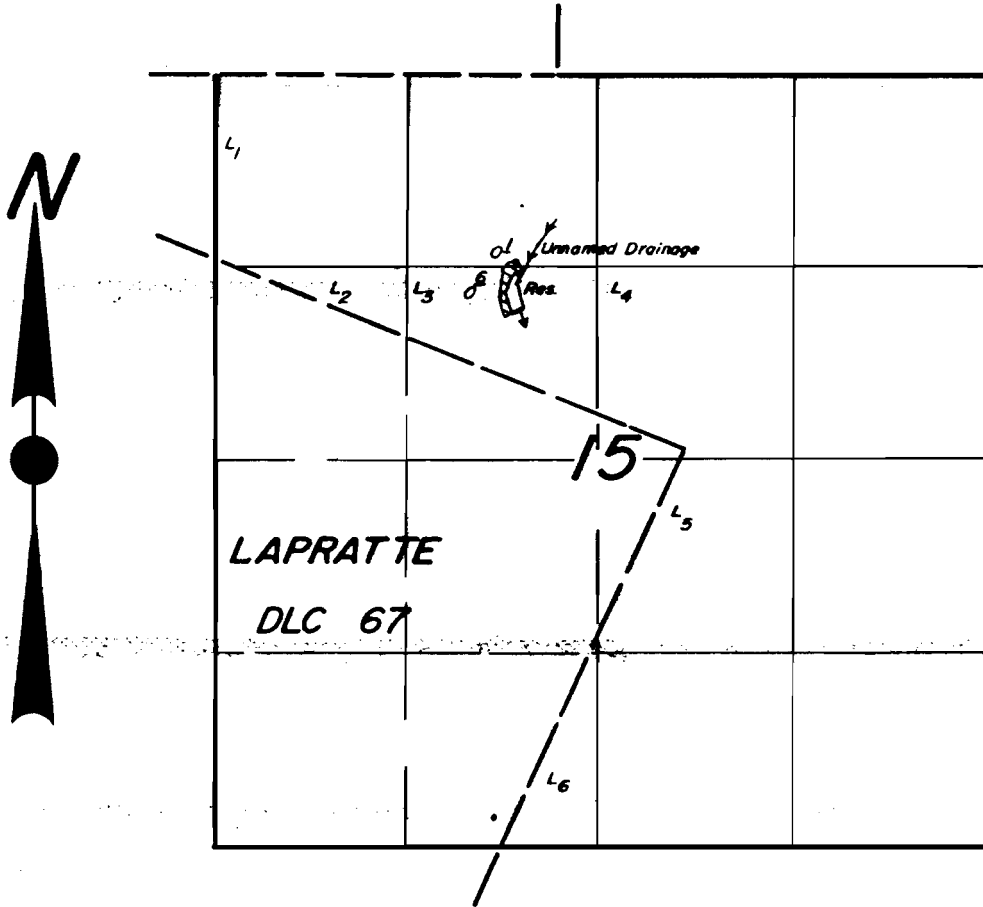

Div. Pt. Loc.: 1040' N. & 540' W. from C 1/4 Sec. 15.

Scale: 1" = 1320'

FINAL PROOF SURVEY
UNDER

R-59383 R-7970
Application No. 59384... Permit No. 44562....
IN NAME OF

FRANK C. HENNY, Jr.

Surveyed May 16, 1984., by Ben Bishop.....