



T.3S., R.4W., W.M.

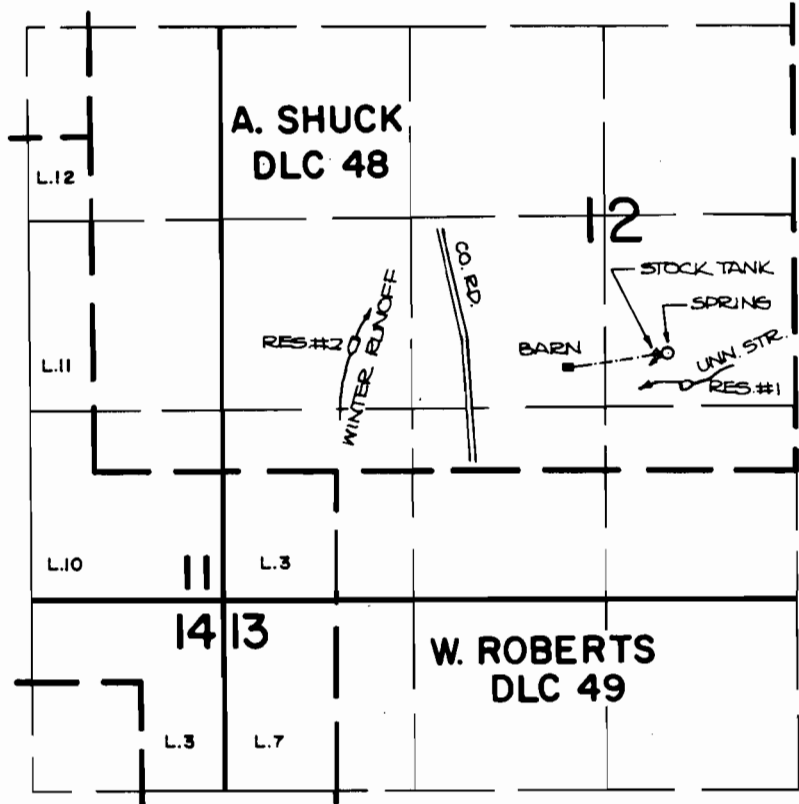

SPRING LOCATION: 950 FT. S. AND 430 FT. E.;
DAM #1 LOCATION: 1150 FT. S. AND 530 FT. E.;
DAM #2 LOCATION: 840 FT. S. AND 1710 FT. W.;
ALL FROM THE CENTER OF SECTION 12.

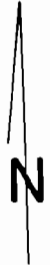

SCALE: 4" = 1 MILE

FINAL PROOF SURVEY
UNDER

R-58766 R-7975
Application No. 58767... Permit No. 44597.....

IN NAME OF
FLORA M. LORD (HAUGEN)
JAMES R. & R. KAREN LINDGREN

Surveyed JULY...5... 1984., by *P. Patten*.....