


T.3S., R.4W., W.M.

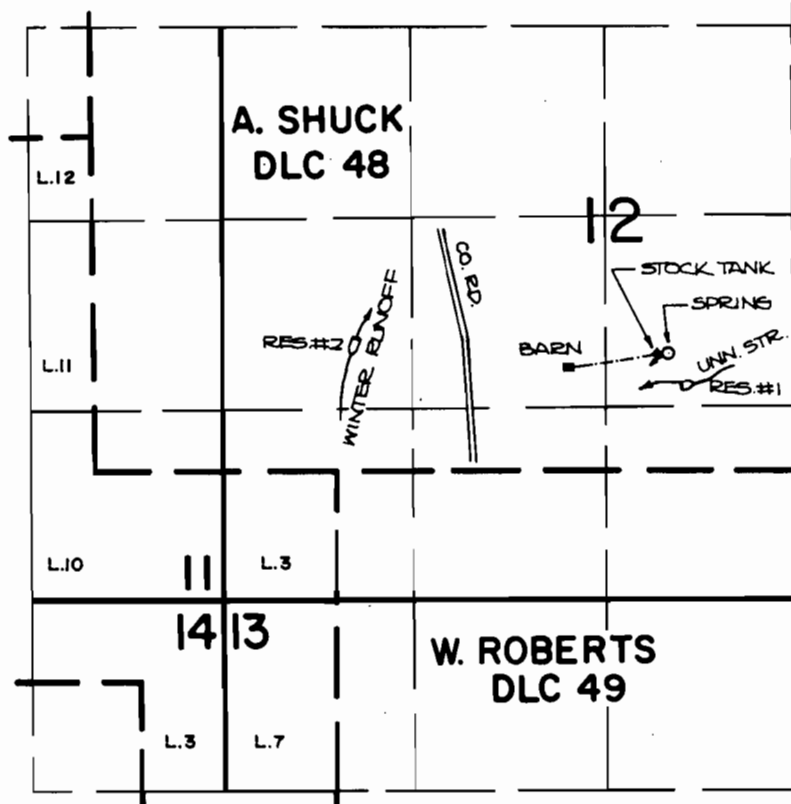

SPRING LOCATION: 950 FT. S. AND 430 FT. E.;  
DAM #1 LOCATION: 1150 FT. S. AND 530 FT. E.;  
DAM #2 LOCATION: 840 FT. S. AND 1710 FT. W.;  
ALL FROM THE CENTER OF SECTION 12.



SCALE: 4" = 1 MILE

**FINAL PROOF SURVEY**  
UNDER

R-58766                      R-7975  
Application No. 58767... Permit No. 44597.....

IN NAME OF  
**FLORA M. LORD (HAUGEN)**  
**JAMES R. & R. KAREN LINDGREN**

Surveyed JULY...5... 1984., by *P. Patten*.....