


T.15S. R.5W.W.M.

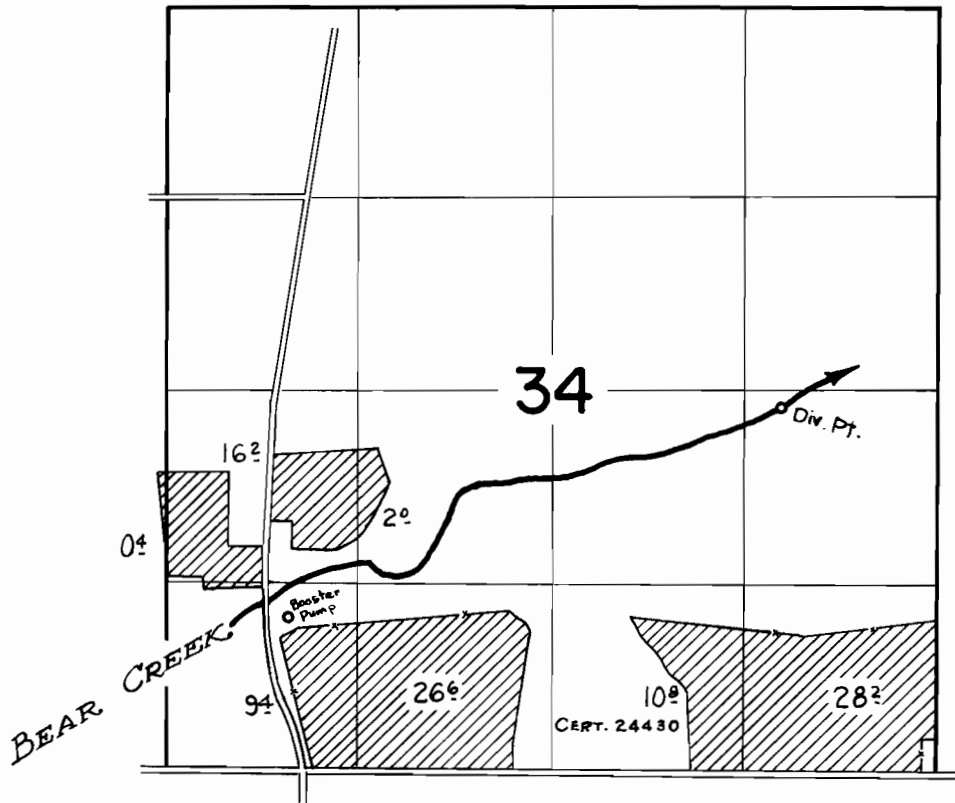

FINAL PROOF SURVEY UNDER

Application No. **32299**.. Permit No. **25525**..
IN NAME OF

JOHN V. CAROTHERS

Surveyed May 8, 1961, by

R. Jackson