


135,

97.

2
7
2
9

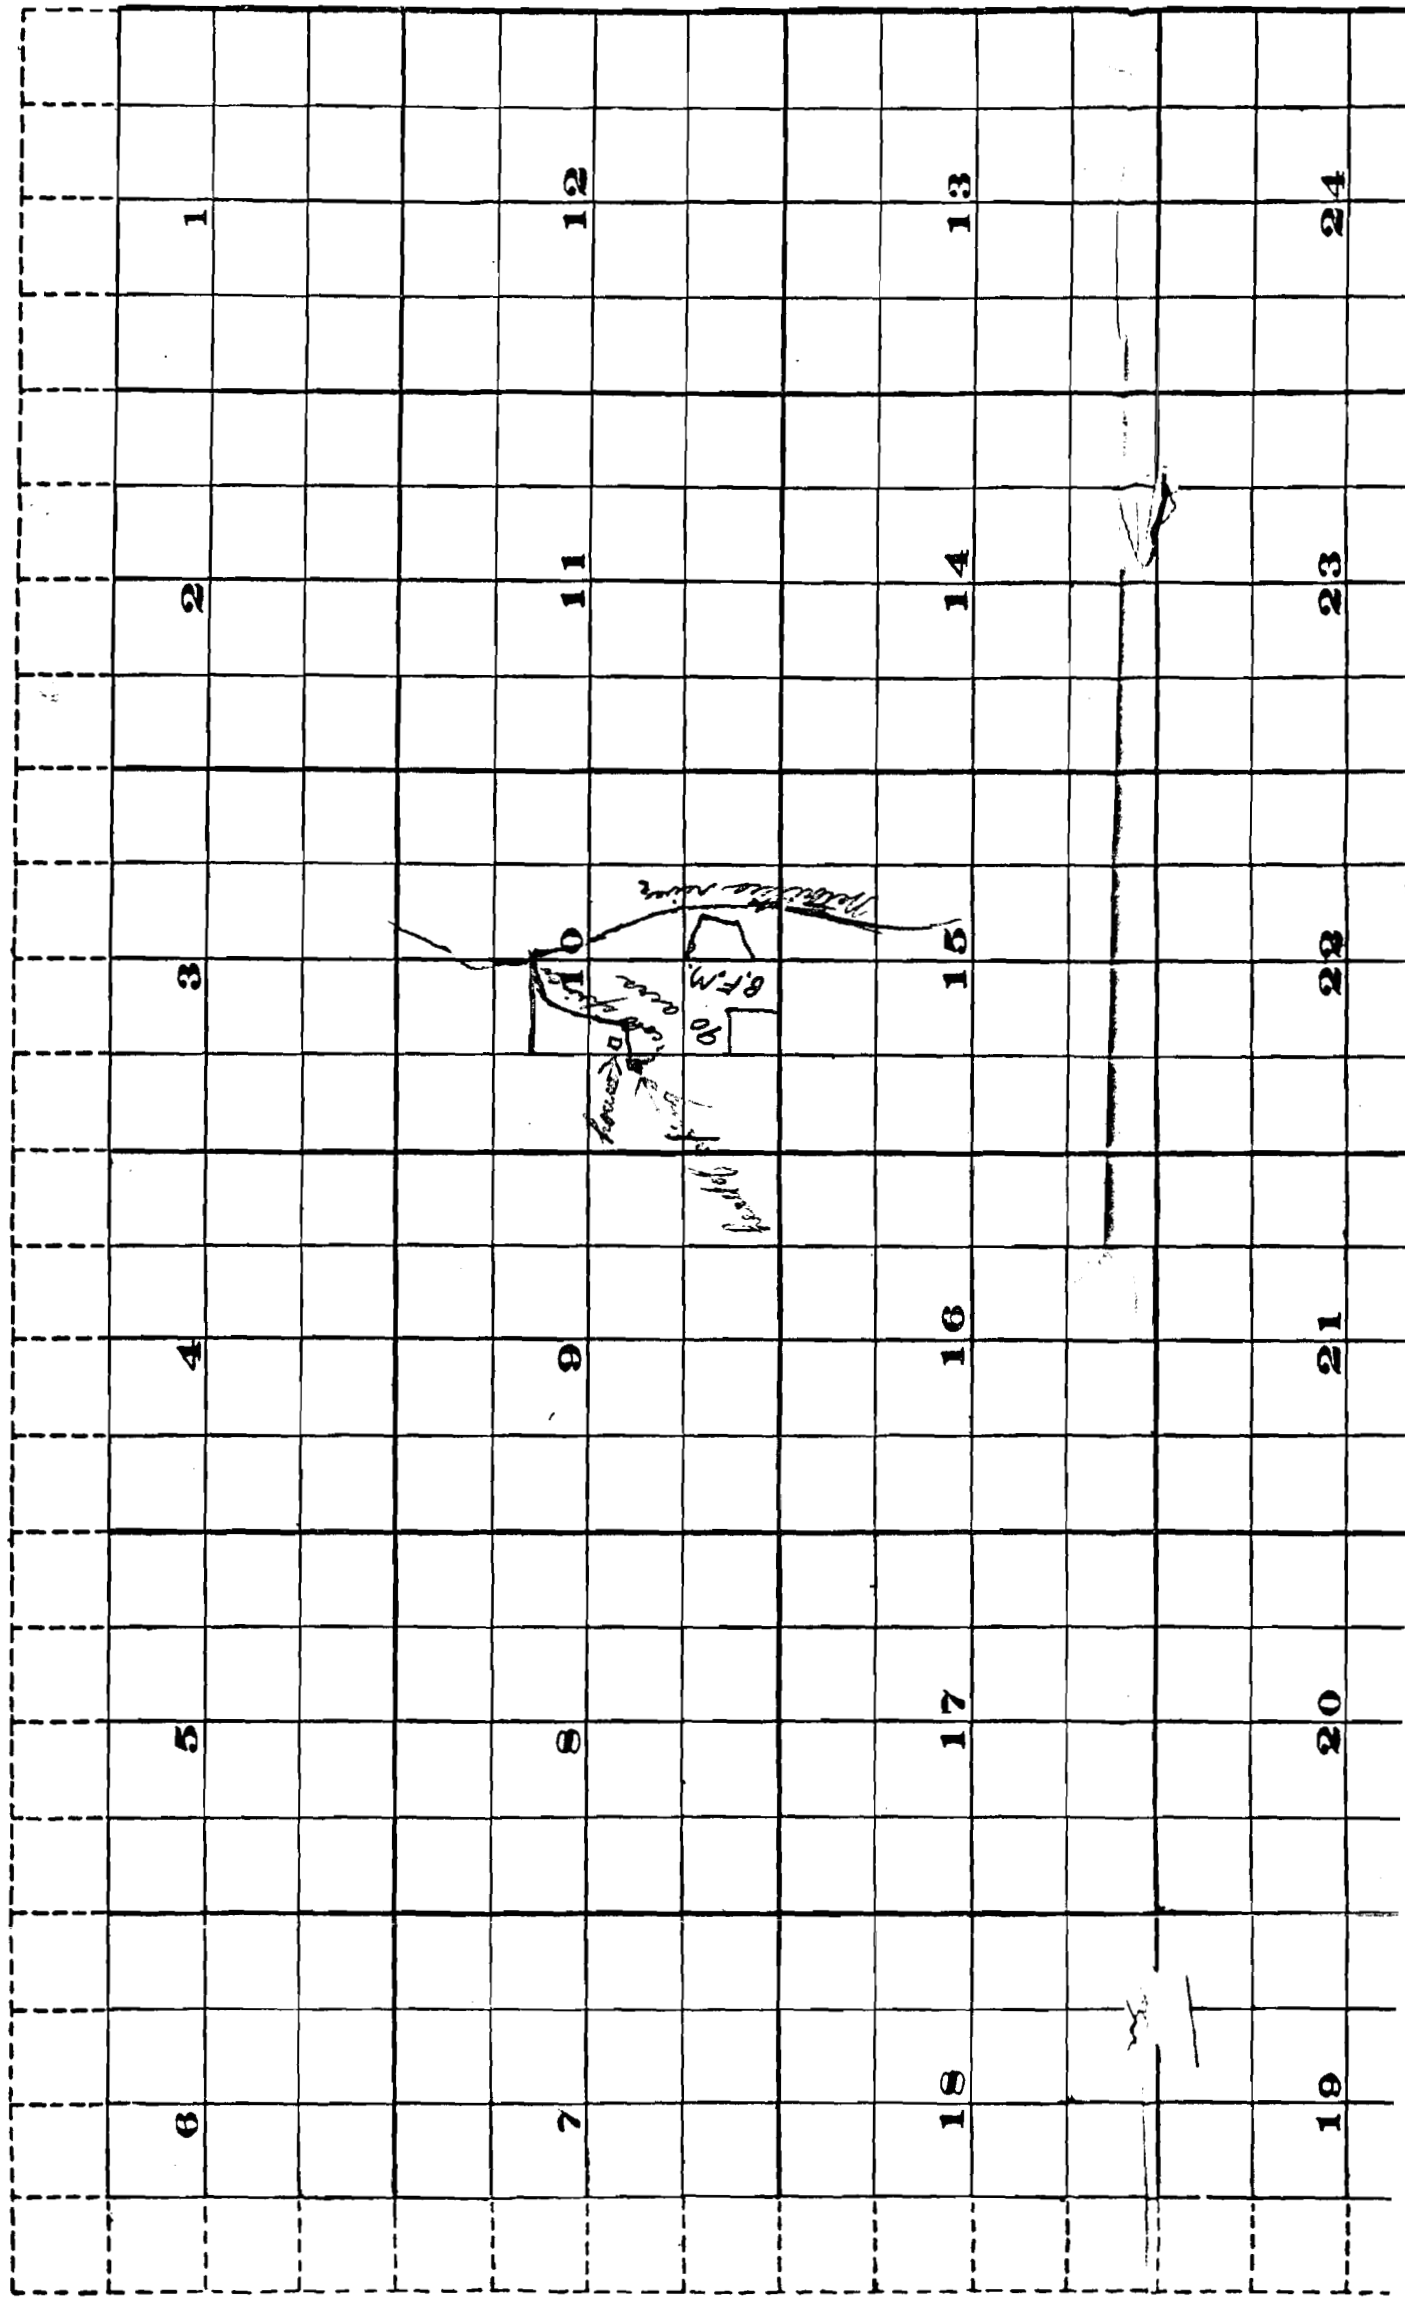

6147
P. J.