


T. 39 S., R. 8 W., W.M.

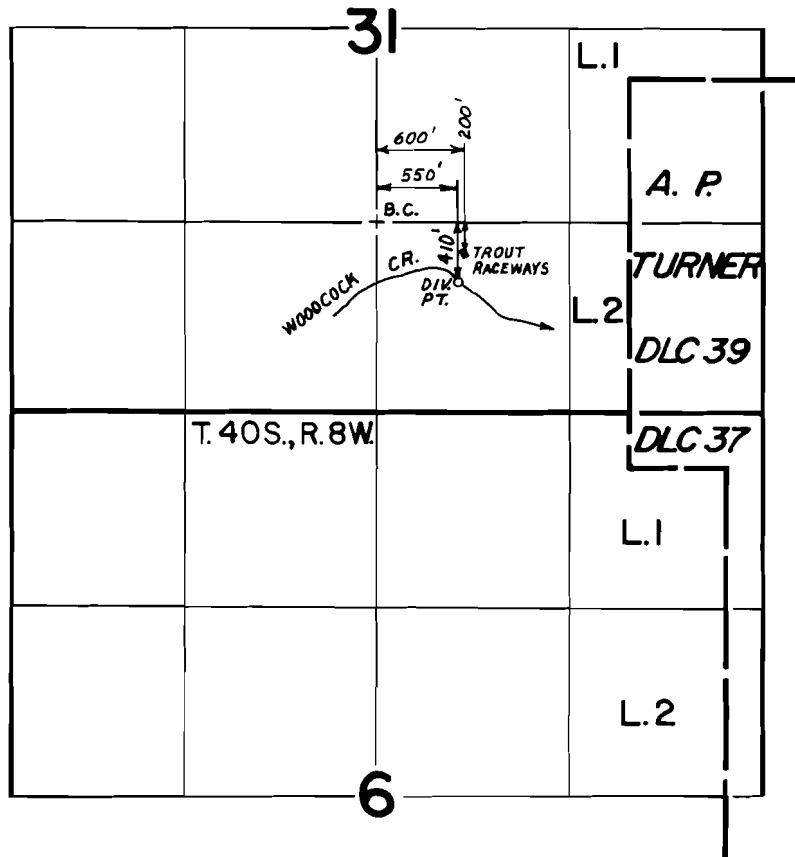

SCALE: 1" = 1320'

FINAL PROOF SURVEY

UNDER

R-59517 R-7986
 Application No. 59555 Permit No. 44635
 IN NAME OF

Dr. ROBERT L. & ILENE WILSON

Surveyed MAR. 28 1984, by B. S. JAMES