


57972 P-4500

57971 R-8164

T. 13S., R. 33E., W.M.

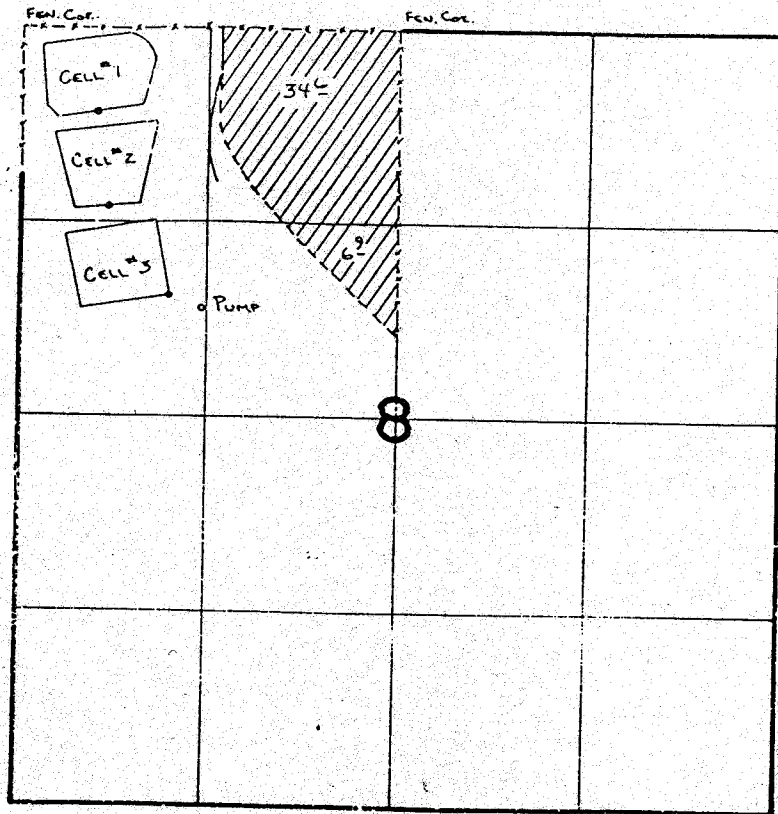

Div. Pt. 1 Loc: 570'S. & 530'E  
 Div. Pt. 2 Loc: 1220'S. & 620'E  
 Div. Pt. 3 Loc: 1820'S & 1050'E } NW Cor. Sec 8

### FINAL PROOF SURVEY

UNDER

15.1" = 132'

R-60512      R-8164  
 Application No. 60513 Permit No. 45007...  
 IN NAME OF

CITY OF PRAIRIE CITY, OREGON.

Surveyed 3-17 19.86, by J. T. ...