


T. 5S., R. 39E., W. M.

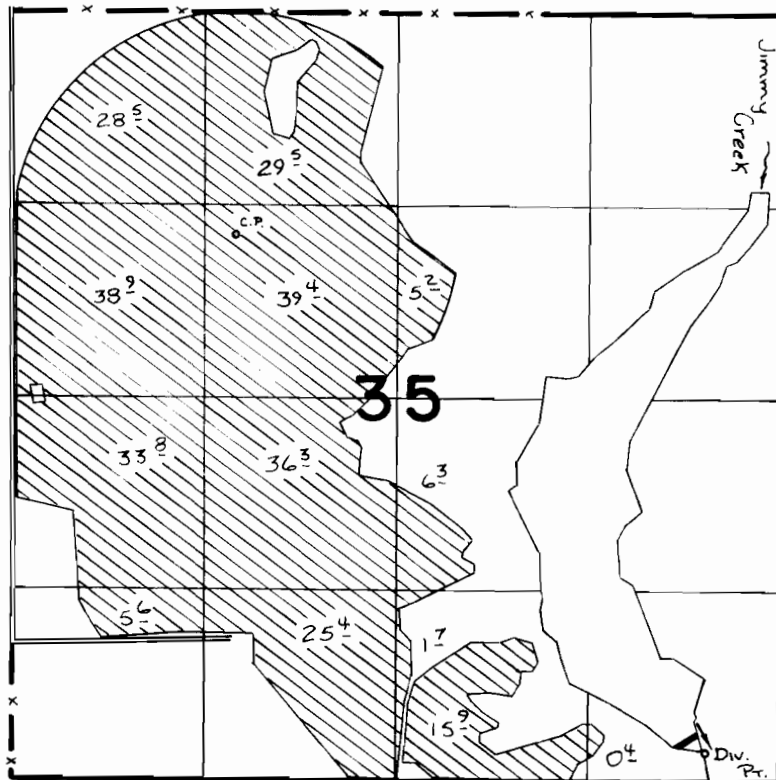

Div. Pt. Located 200' N. & 510' W From SE COR. SEC. 35

SCALE: 1" = 1320'

FINAL PROOF SURVEY UNDER

R-60930 R-8192
Application No. **60931**... Permit No. **45274**....
IN NAME OF

RUFENACHT... LAND & CATTLE... CO.

Surveyed 7-17, 18, 25, 1985, by **V. L. Church**.....