


T.4S., R.3W., W.M.

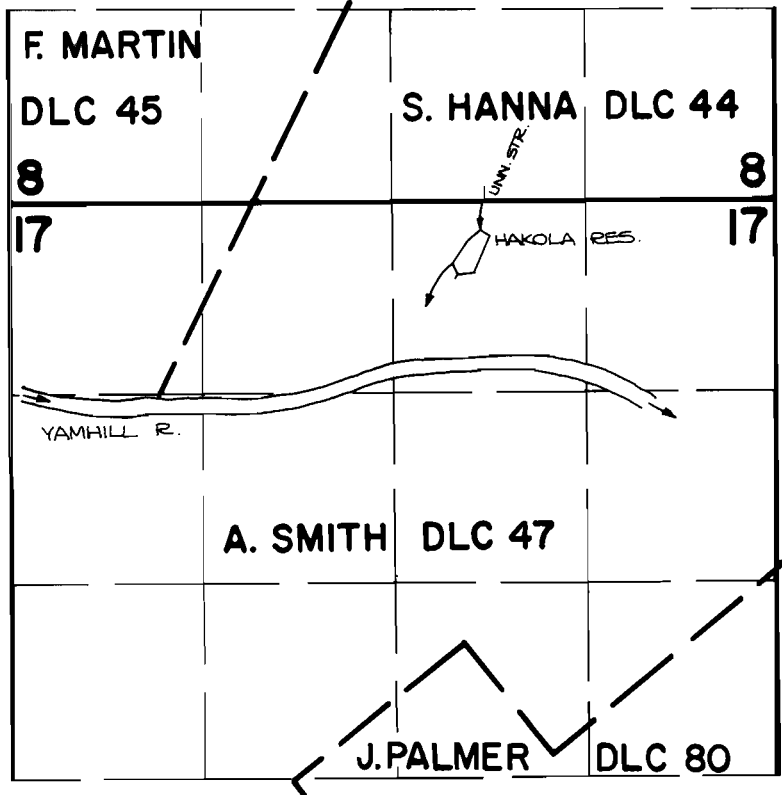

DAM LOCATION: 500 FT. S. AND 2170 FT. W. FROM THE N.E. CORNER OF SECTION 17.



FINAL PROOF SURVEY UNDER

SCALE: 4"=1 MILE

R-61459 R-8251
Application No. 61460.. Permit No. 45642.....
IN NAME OF

.....DON HAKOLA.....

Surveyed MAY 17, 1984, by P. Page