


T.8S.,R.5W.,W.M.

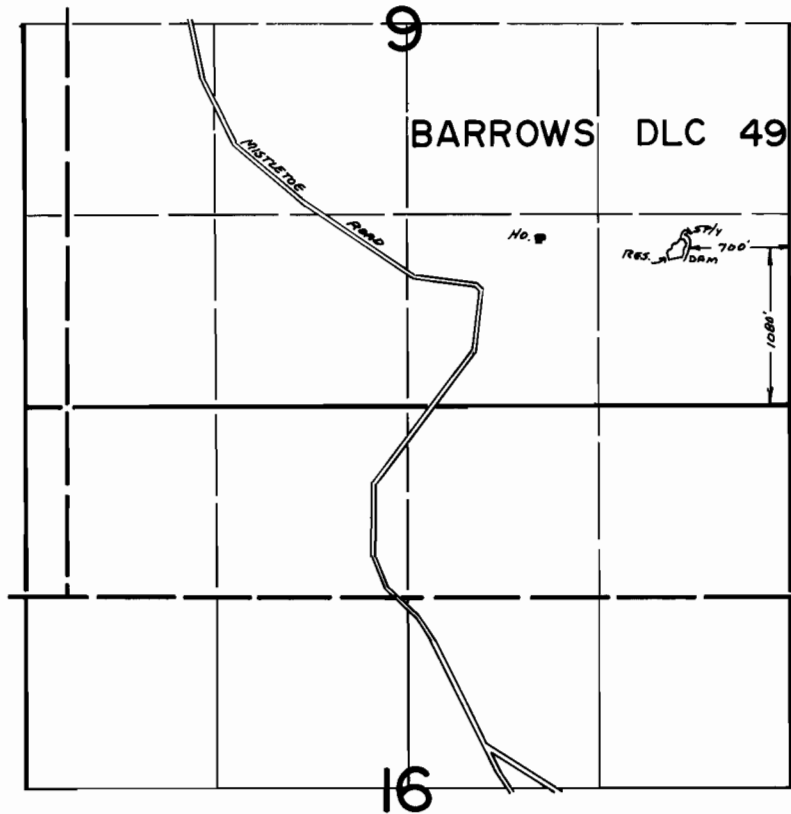

FINAL PROOF SURVEY
UNDER

R-61580 R-8260
Application No. 61581... Permit No. 45706.....
IN NAME OF

.....ROBERT L. MULDER.....

Surveyed Oct...15... 19.81., by ...L...TOLL.....