T.8S.,R.5W.,W.M.

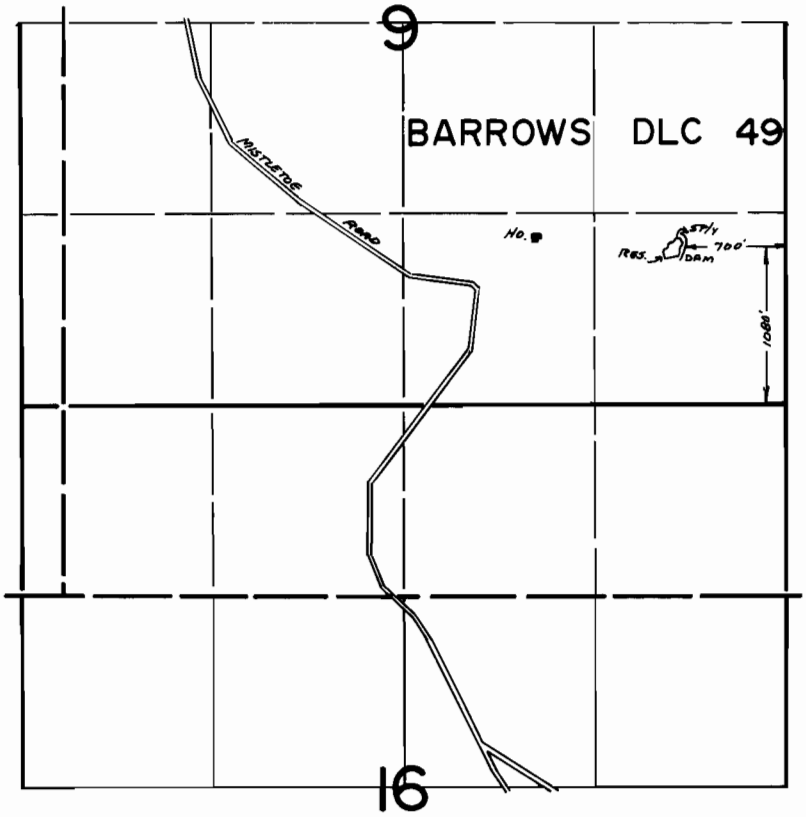

FINAL PROOF SURVEY

UNDER

Application No. R-61580 61581 Permit No. R-8260 45706

IN NAME OF

ROBERT L. MULDER

Surveyed Oct. 15 19 81, by L. TOLL

DFP-2P-15
PTS 1981-L