


T. 4 S., R. 5 W., W. M.

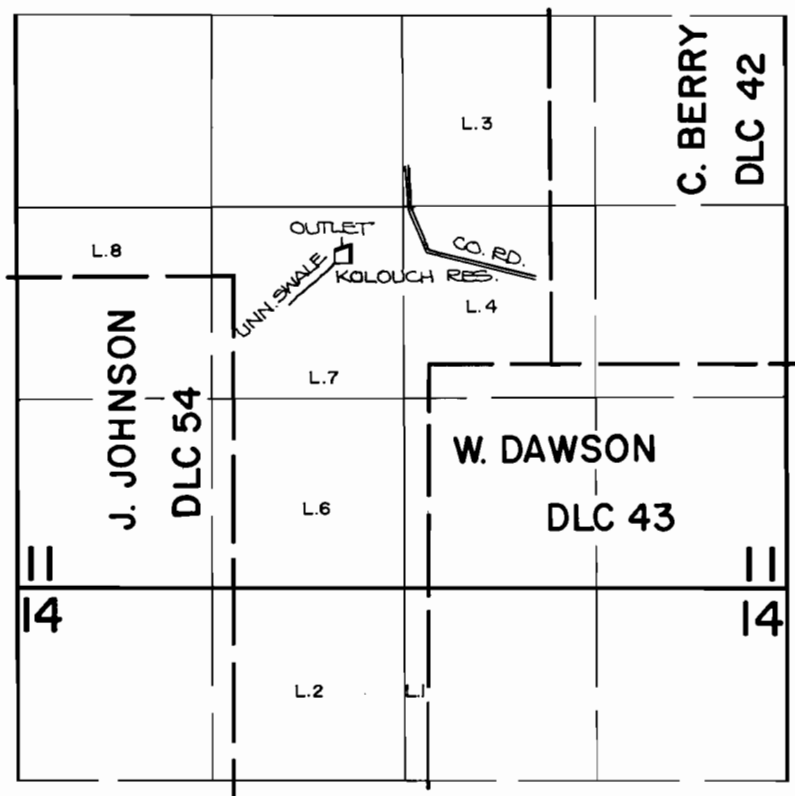

DAM LOCATION: 280 FT. S. AND 370 FT. W. FROM THE CENTER OF SECTION 11.

FINAL PROOF SURVEY UNDER

N

SCALE: 4" = 1 MILE

Application No. R-61731 Permit No. R-8285
IN NAME OF

WALTER J. KOLOUCH

Surveyed JULY 25, 1984, by P. P. Patten