


T. 39 & 40 S., R. 8 W., W.M.

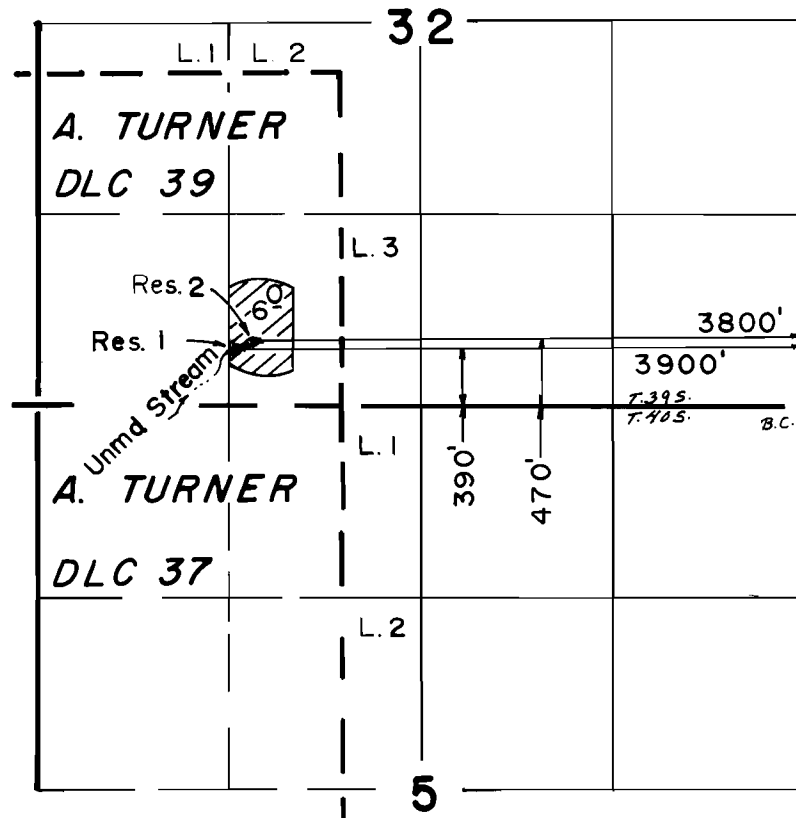

**FINAL PROOF SURVEY**  
UNDER

R-64951      R-8663  
Application No. **64952** Permit No. **47599**  
IN NAME OF

**ARNOLD H. & MARIAN T. ANDERSON**

Surveyed APR... 1986, by B...S...JAMES..