


T. 11 S., R. 9 W., W.M.

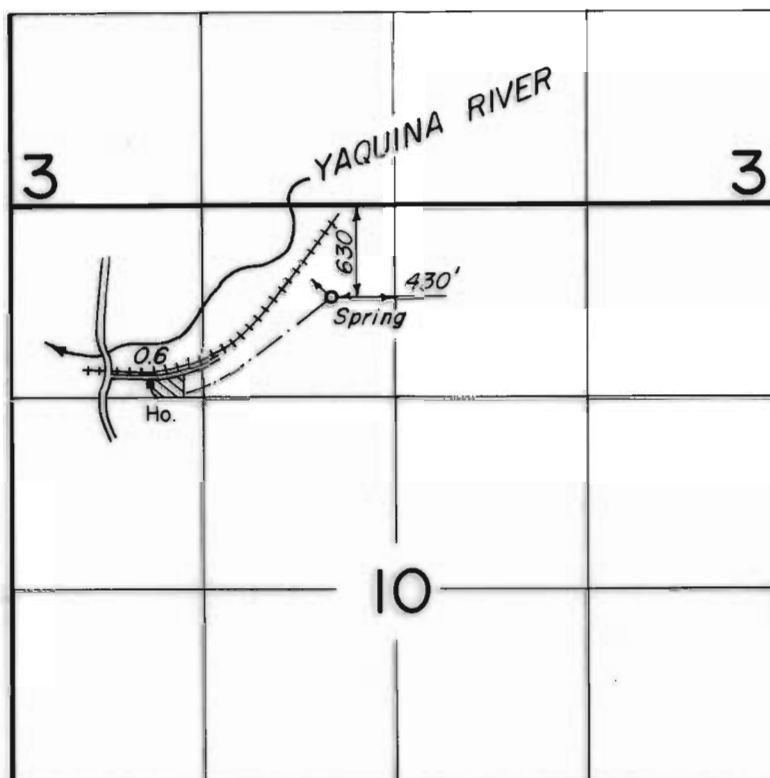

FINAL PROOF SURVEY
UNDER

Application No. 49370 Permit No. 37009
IN NAME OF

WILLIAM L. ATKINS

Surveyed Sept 26, 1979 by AC Brown