


T. 41 S., R. 1 W. & 1 E., W. M.

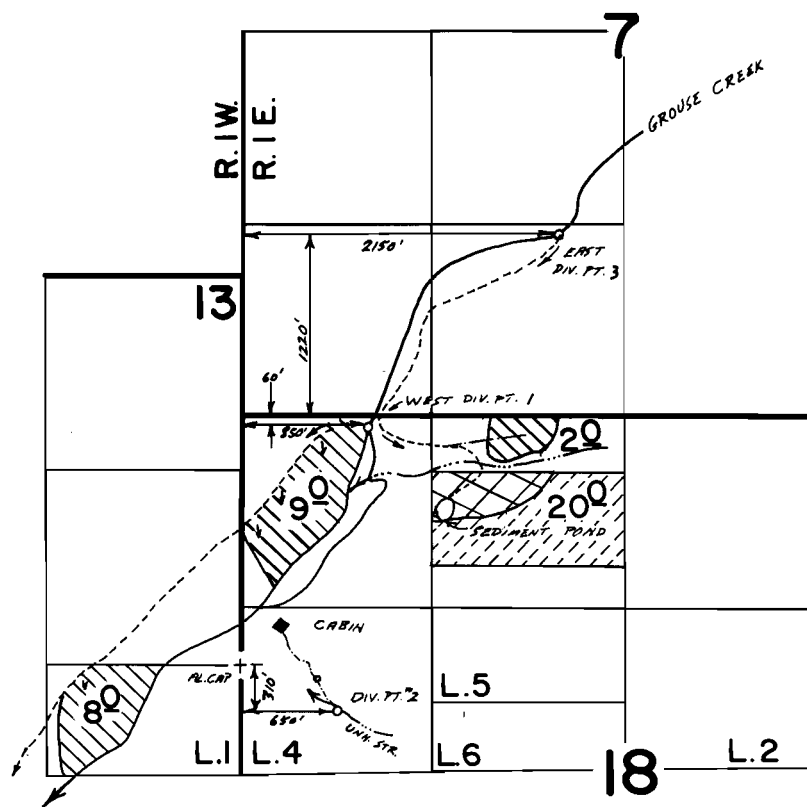

Scale 1"=1320'

FINAL PROOF SURVEY UNDER

- IRRIGATION
- MINED
- FUTURE MINING

Application No. 52213... Permit No. 39309.....
IN NAME OF

.....EDWIN.....B.....CASWELL.....

Surveyed Aug....7.... 19.86, by B.S. JAMES.....