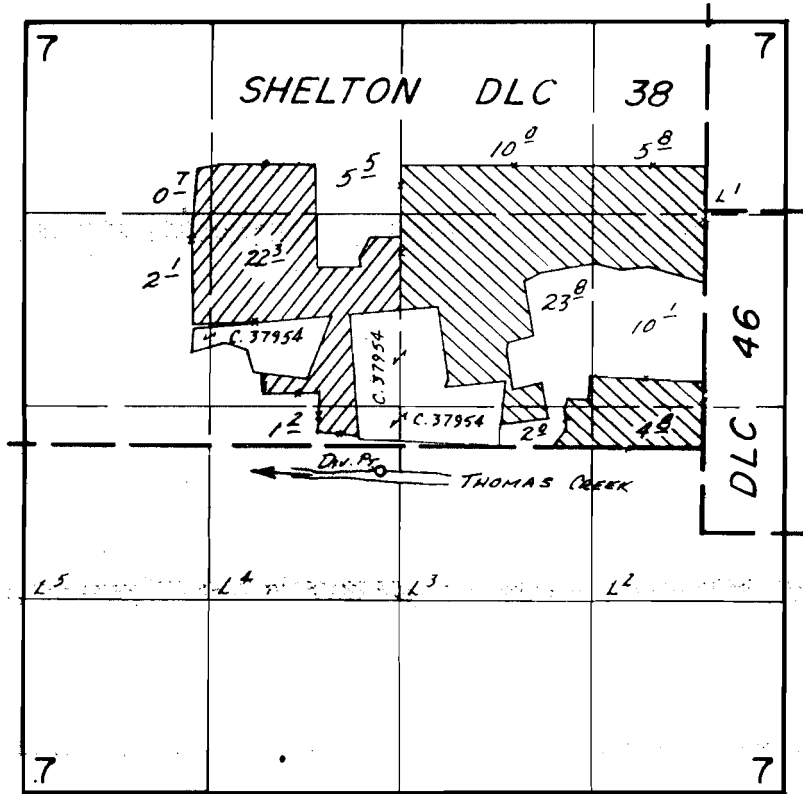

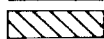


# T. 10S., R. 1E., W. 1M.



*Div. Pt. Loc.: 190' S. & 2200' W. FROM SE COR. SHELTON DLC 38.*

 HICKEN  
 EARLY

SCALE: 1" = 1320'

## FINAL PROOF SURVEY UNDER

Application No. 53670.. Permit No. 40129.....  
IN NAME OF

J. P. &/or C. L. EARLY & D. L. & M. C. HICKEN

Surveyed June 7, 1982, by L. M. TOLL.....  
Apr. 26 1984 B. W. BISHOP